


T. 35 S., R. 11 W., W. M.

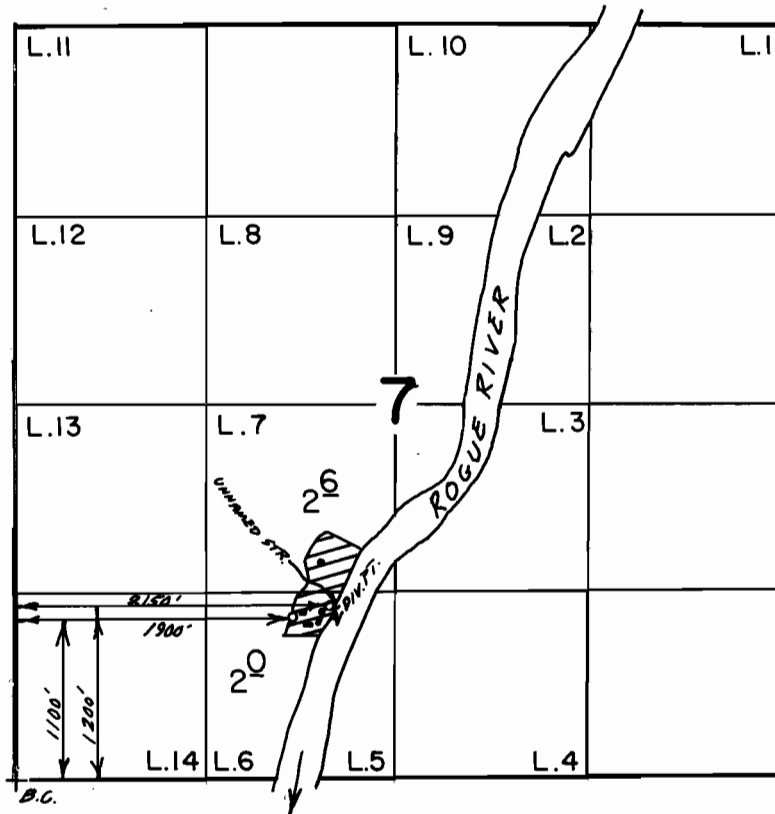

Scale 1" = 1320'

**FINAL PROOF SURVEY
UNDER**

Application No. 58414 Permit No. 44236
IN NAME OF

ROBERT L. LOGAN & BILL SCHERBARTH

Surveyed July 23, 1988, by B.S. JAMES.....