


T. 38S., R. 4W., W.M.

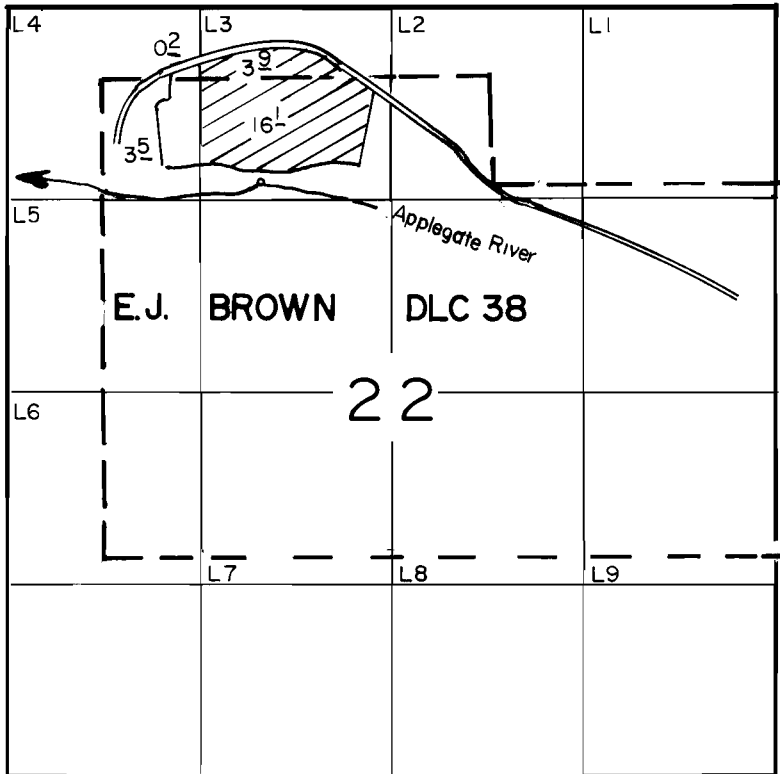

Div Pt Loc 1220' S & 1720' E From The NW Corner Of Section 22

SCALE: 1" = 1320'

FINAL PROOF SURVEY
UNDER

Application No. 62358.... Permit No. 46515.....
IN NAME OF

.....**MONTY G & CAROL HOLST**.....

Surveyed NOV. 22, 1989., by B.S. JAMES.....