


T. 35S., R. 11W., W.M.

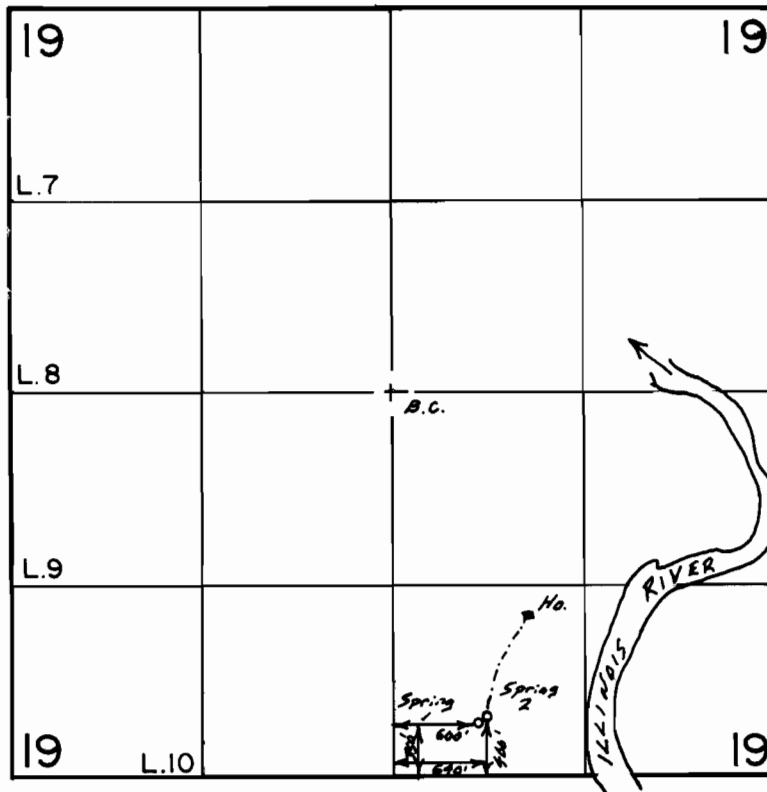

Scale 1" = 1320'

FINAL PROOF SURVEY
UNDER

Application No. 68273 Permit No. 49233...
IN NAME OF

...ROBERT D. CAUGHELL...

Surveyed July 30, 1989, by B.S. JAMES...