


T.32 S.R.15 W.W.M.

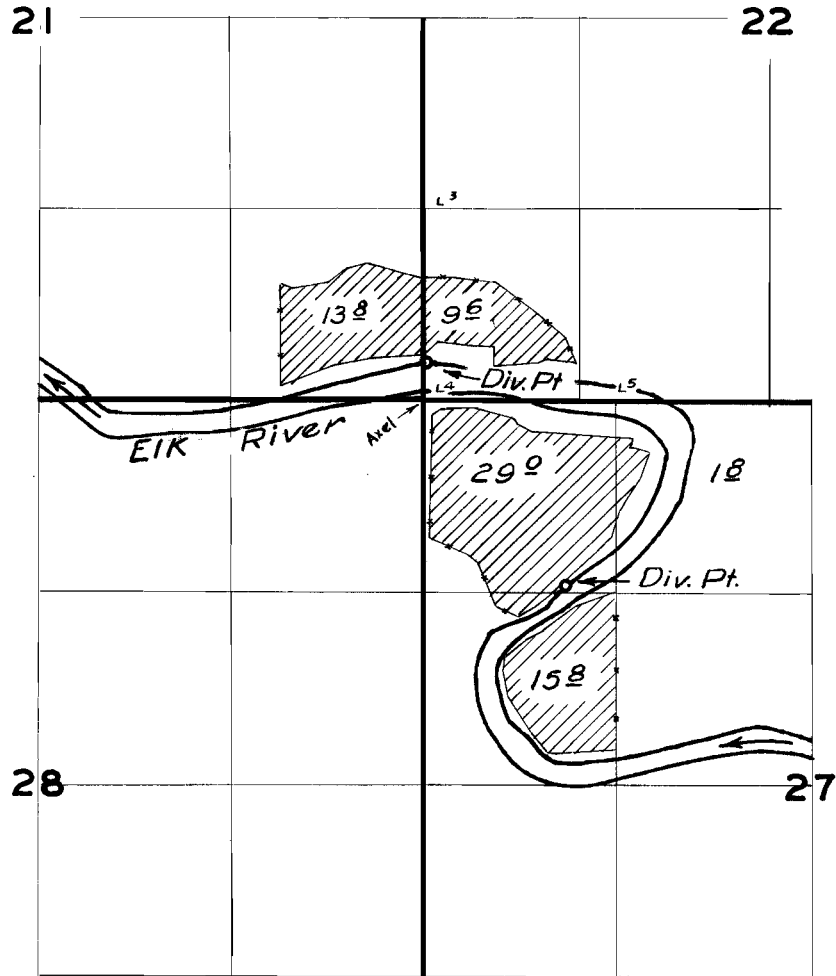

FINAL PROOF SURVEY
UNDER

Application No. 27601 Permit No. 21744
IN NAME OF

Clyde L. Wagner

Surveyed 16 April 1958, by M. Bish