


T.41S., R.13W., W.M.

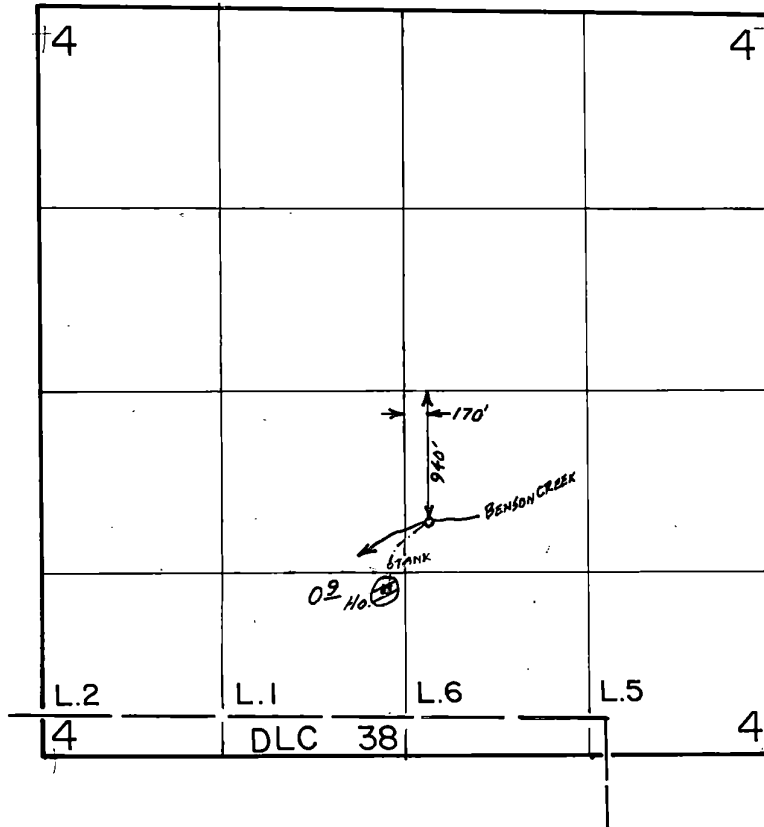

Scale 1" = 1320'

FINAL PROOF SURVEY
UNDER

Transfer No. 5510

Application No. Permit No.
IN NAME OF

VERN R. & DOROTHY J. GARVIN

Surveyed Sept. 25, 1991., by B.S. JAMES....