


FINAL PROOF MAP:  
CHANGE IN POINT OF APPROPRIATION  
LLOYD MILES  
LOCATED IN SECTION 2,  
TOWNSHIP 27 SOUTH, RANGE 15 EAST,  
WILLAMETTE MERIDIAN, IN  
LAKE COUNTY, OREGON

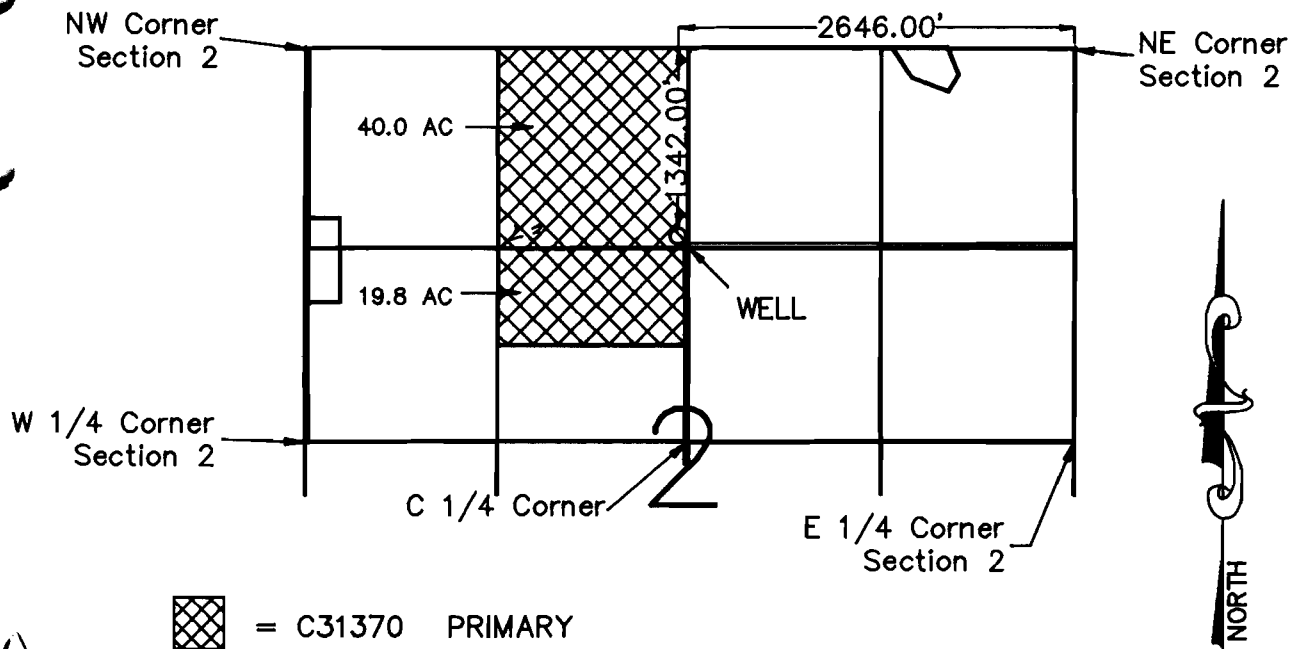


T-6298 TOTAL IRRIGATED AREA = 59.8 ACRES

SCALE: 1"=1320'

I, Michael W. Tye, Certified Water Right Examiner in the State of Oregon, hereby certify that this final proof map was prepared under my direct supervision.

The preparation of this map is for the purpose of identifying the location of the water right only and has no intent to provide dimensions or locations of property ownership lines.

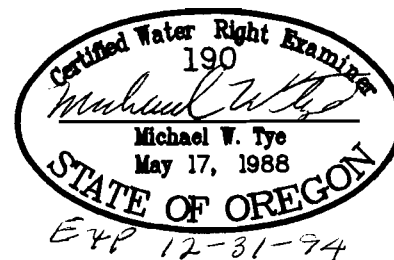

SCALE	1"=1320'	DATE	12-17-92	SURVEY BY	MT&BM	DRAWN BY	P.A.R.	ORDER NO.	3101C
-------	----------	------	----------	-----------	-------	----------	--------	-----------	-------

**SUN COUNTRY ENGINEERING & SURVEYING, INC.**  
 61555 PARRELL ROAD BEND, OREGON 97702 PHONE 382-8882