


14818

T.3N.R.10E.W.M

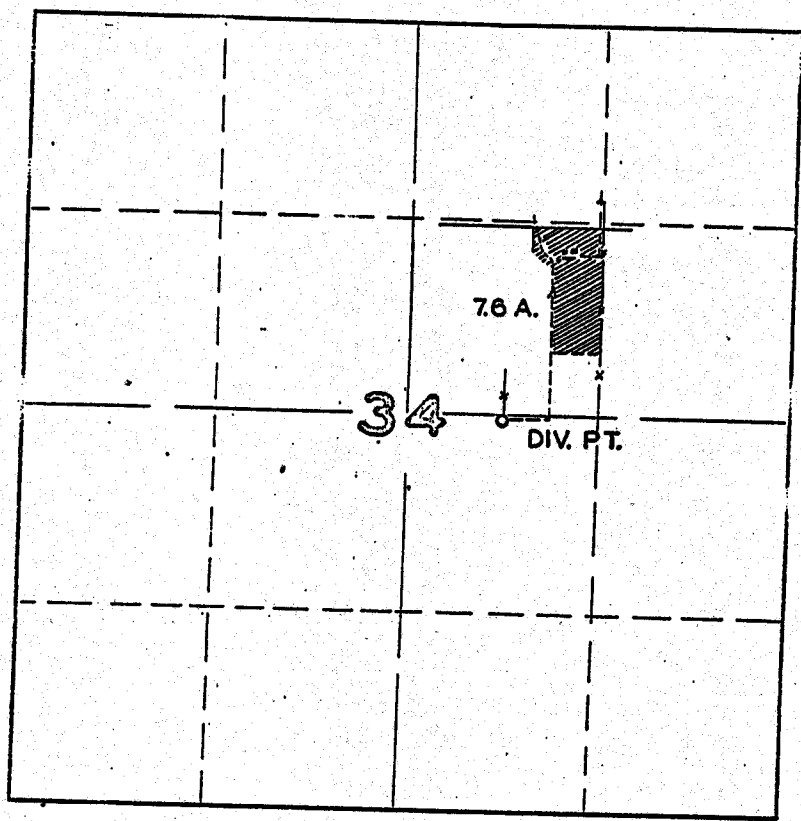

**FINAL PROOF SURVEY**  
UNDER

Application No. 19231... Permit No. 14818...  
IN NAME OF

..... **HARRY R. LOWE** .....

Surveyed JUNE 13 1950., by H.L. COFFMAN.