





COLUMBIA

RIVER

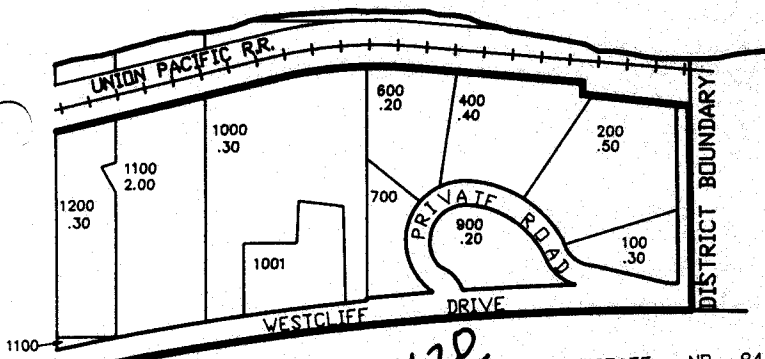

Primary

Supplemental

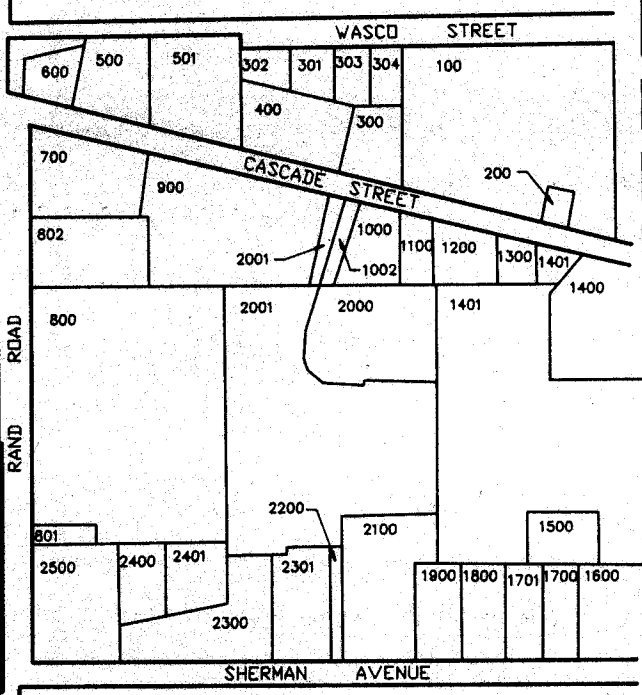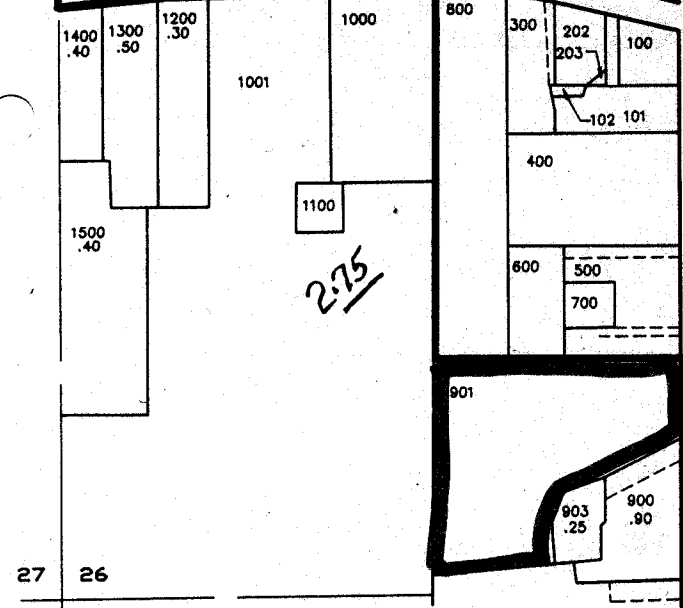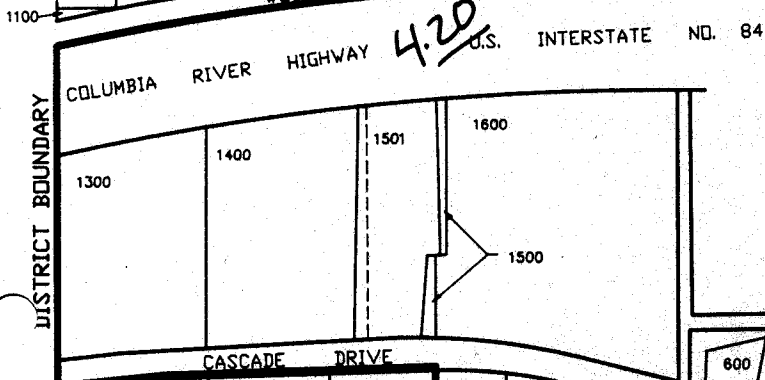

Primary
Supplements
9.20/1

