


COLUMBIA

RIVER

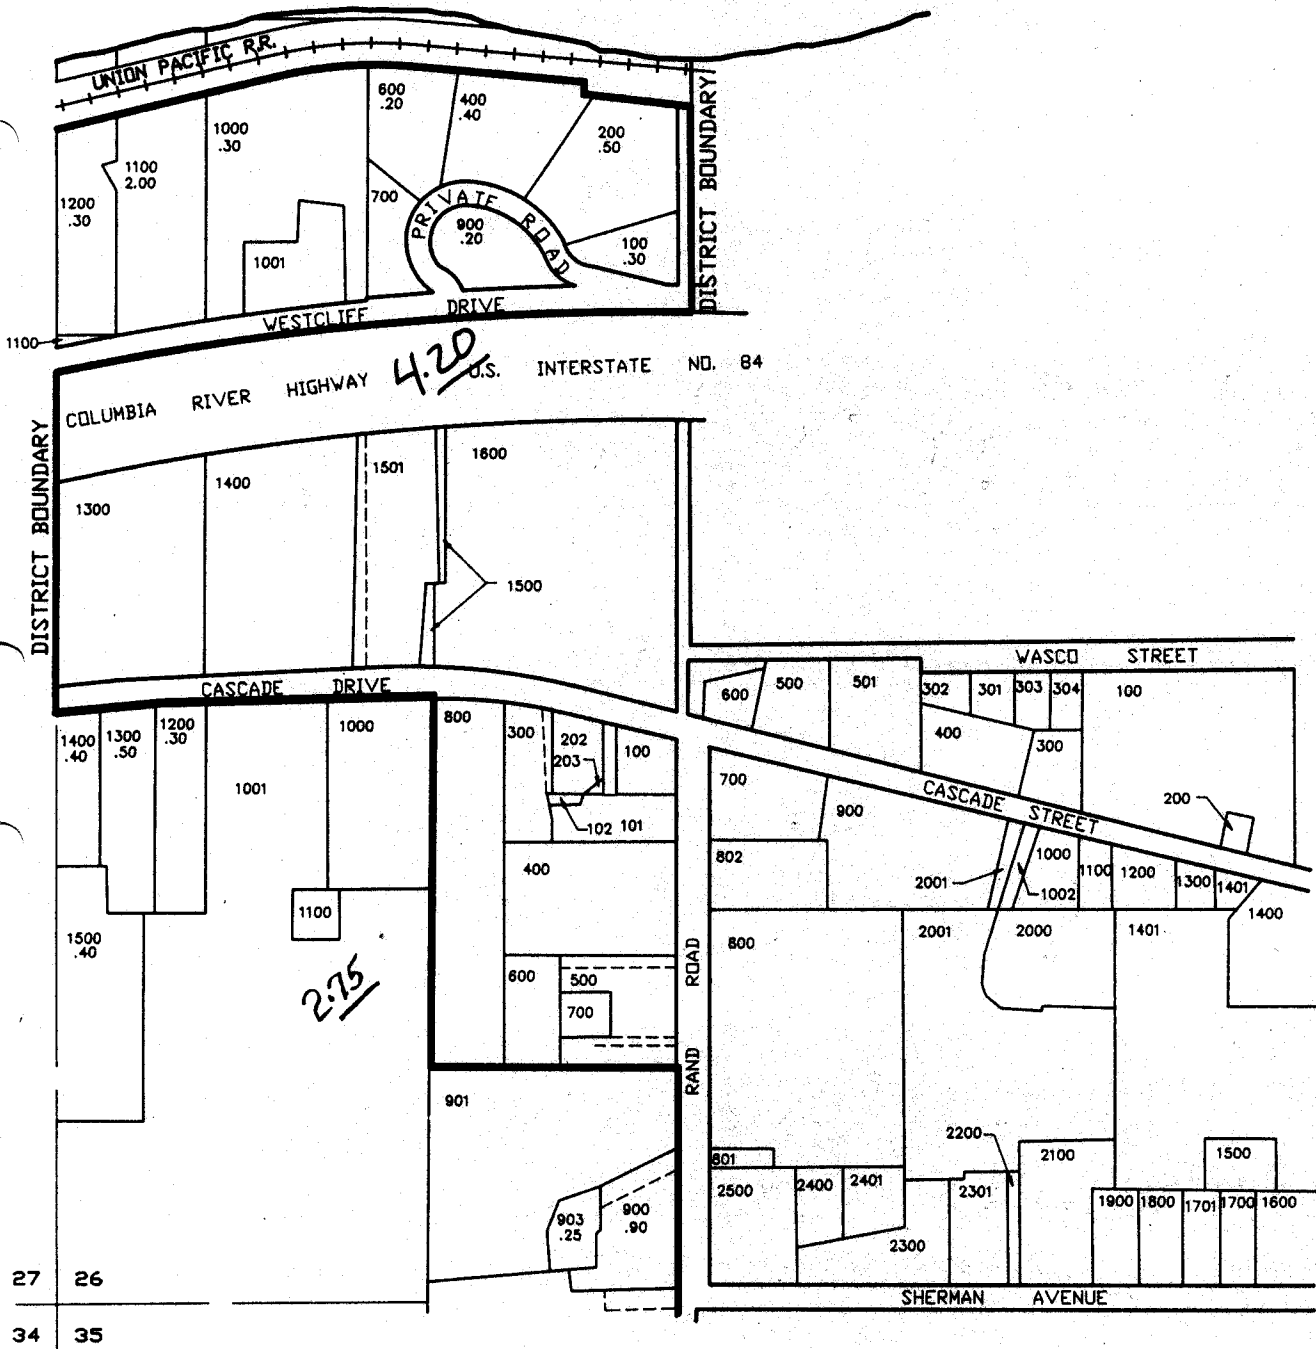

1100
COLUMBIA RIVER HIGHWAY 4.20 U.S. INTERSTATE NO. 84

2.75

27 26
34 35