


T. 3N., R. 10E., W.M.

P# 38940

SEC. 26

NE Cor.  
NW 1/4 SW 1/4

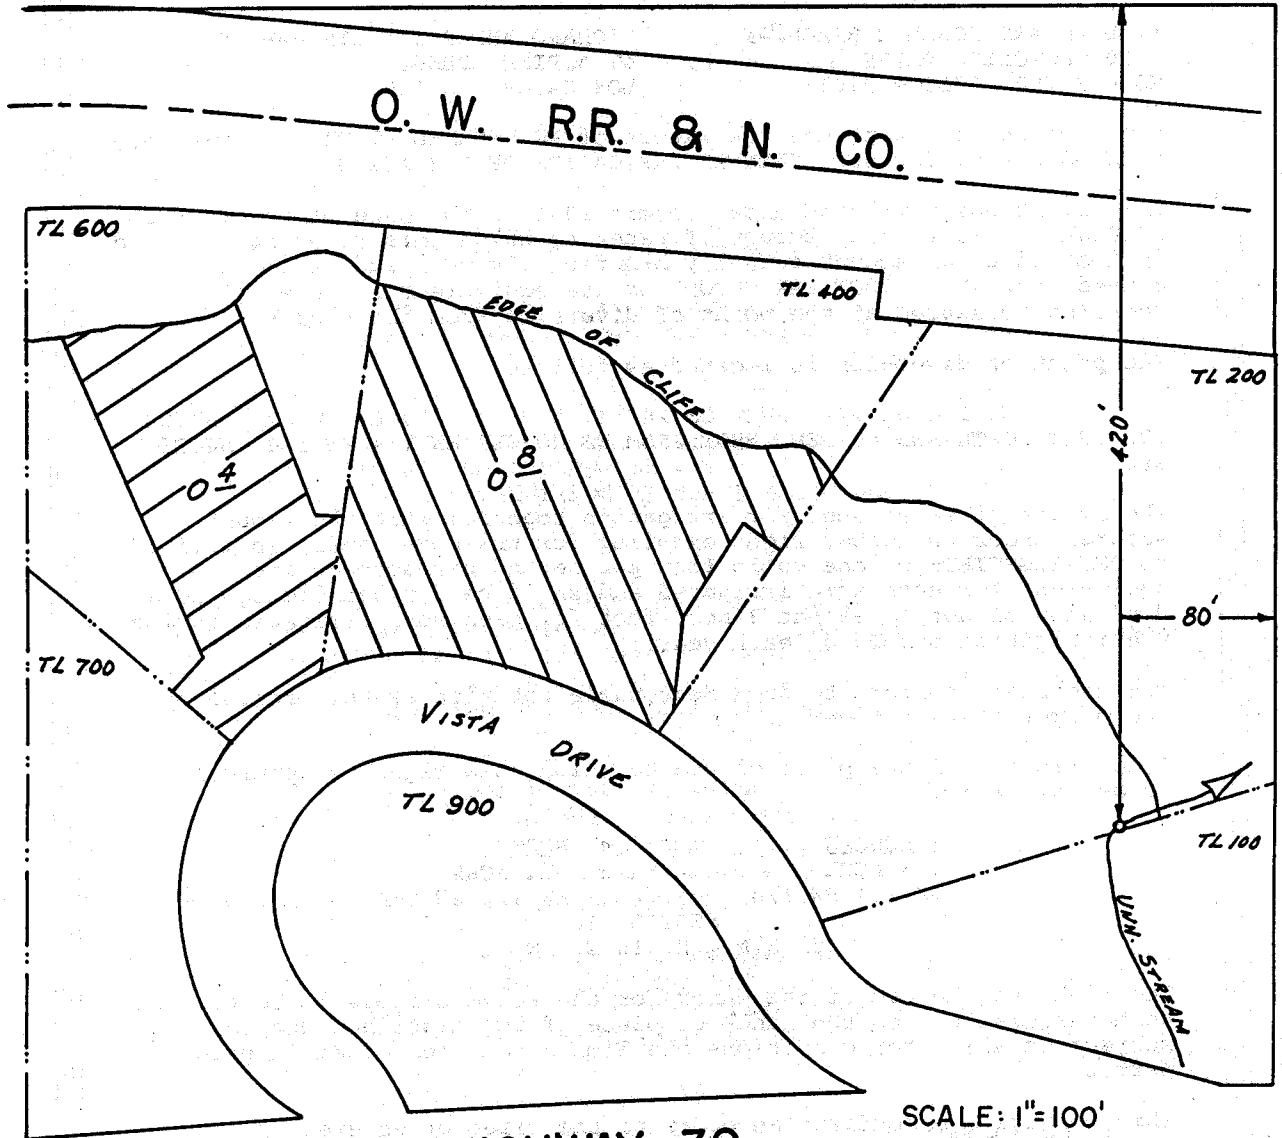

U.S. HIGHWAY 30  
FINAL PROOF SURVEY  
UNDER

SCALE: 1"=100'

 KRIVAK  
 TONN

Application No. 51639... Permit No. 38940.....  
IN NAME OF

ANTON B. KRIVAK & AUDREY M. TONN

Surveyed APR. 16... 1980, by R.G. MUCKEN.....

CHAIN SURVEY &  
ASSESSOR PLAT 508