


T. 2N. R. 10E. W.M.

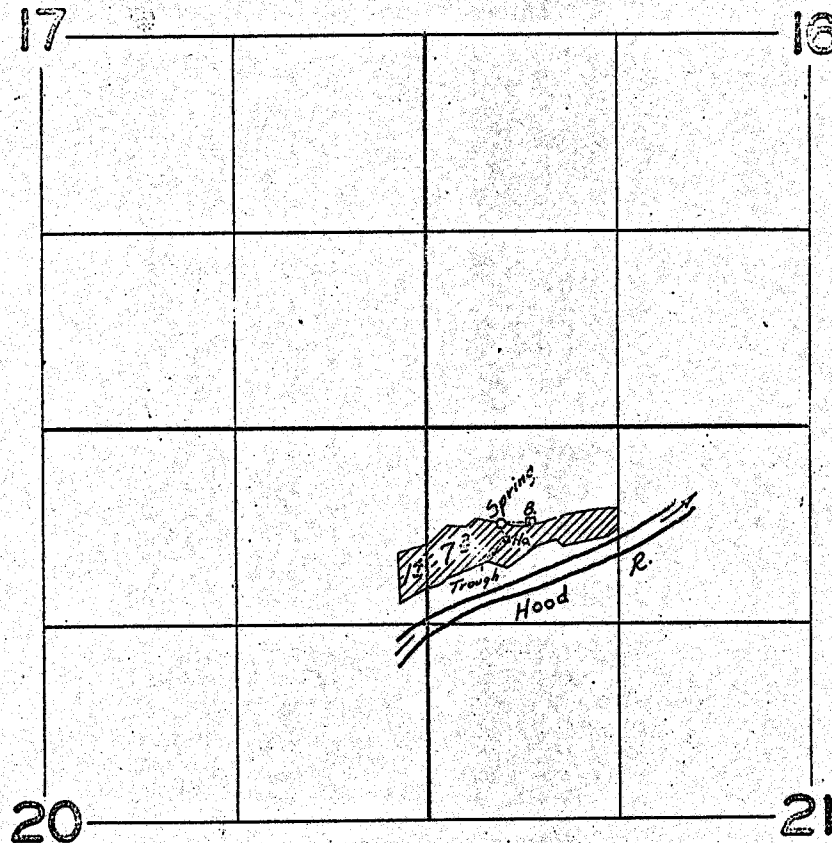

**FINAL PROOF SURVEY**  
UNDER

Application No. 21202 Permit No. 16619  
IN NAME OF

RUSSELL RAYOT

Surveyed Apr. 25 1957, by C.O. Bartel