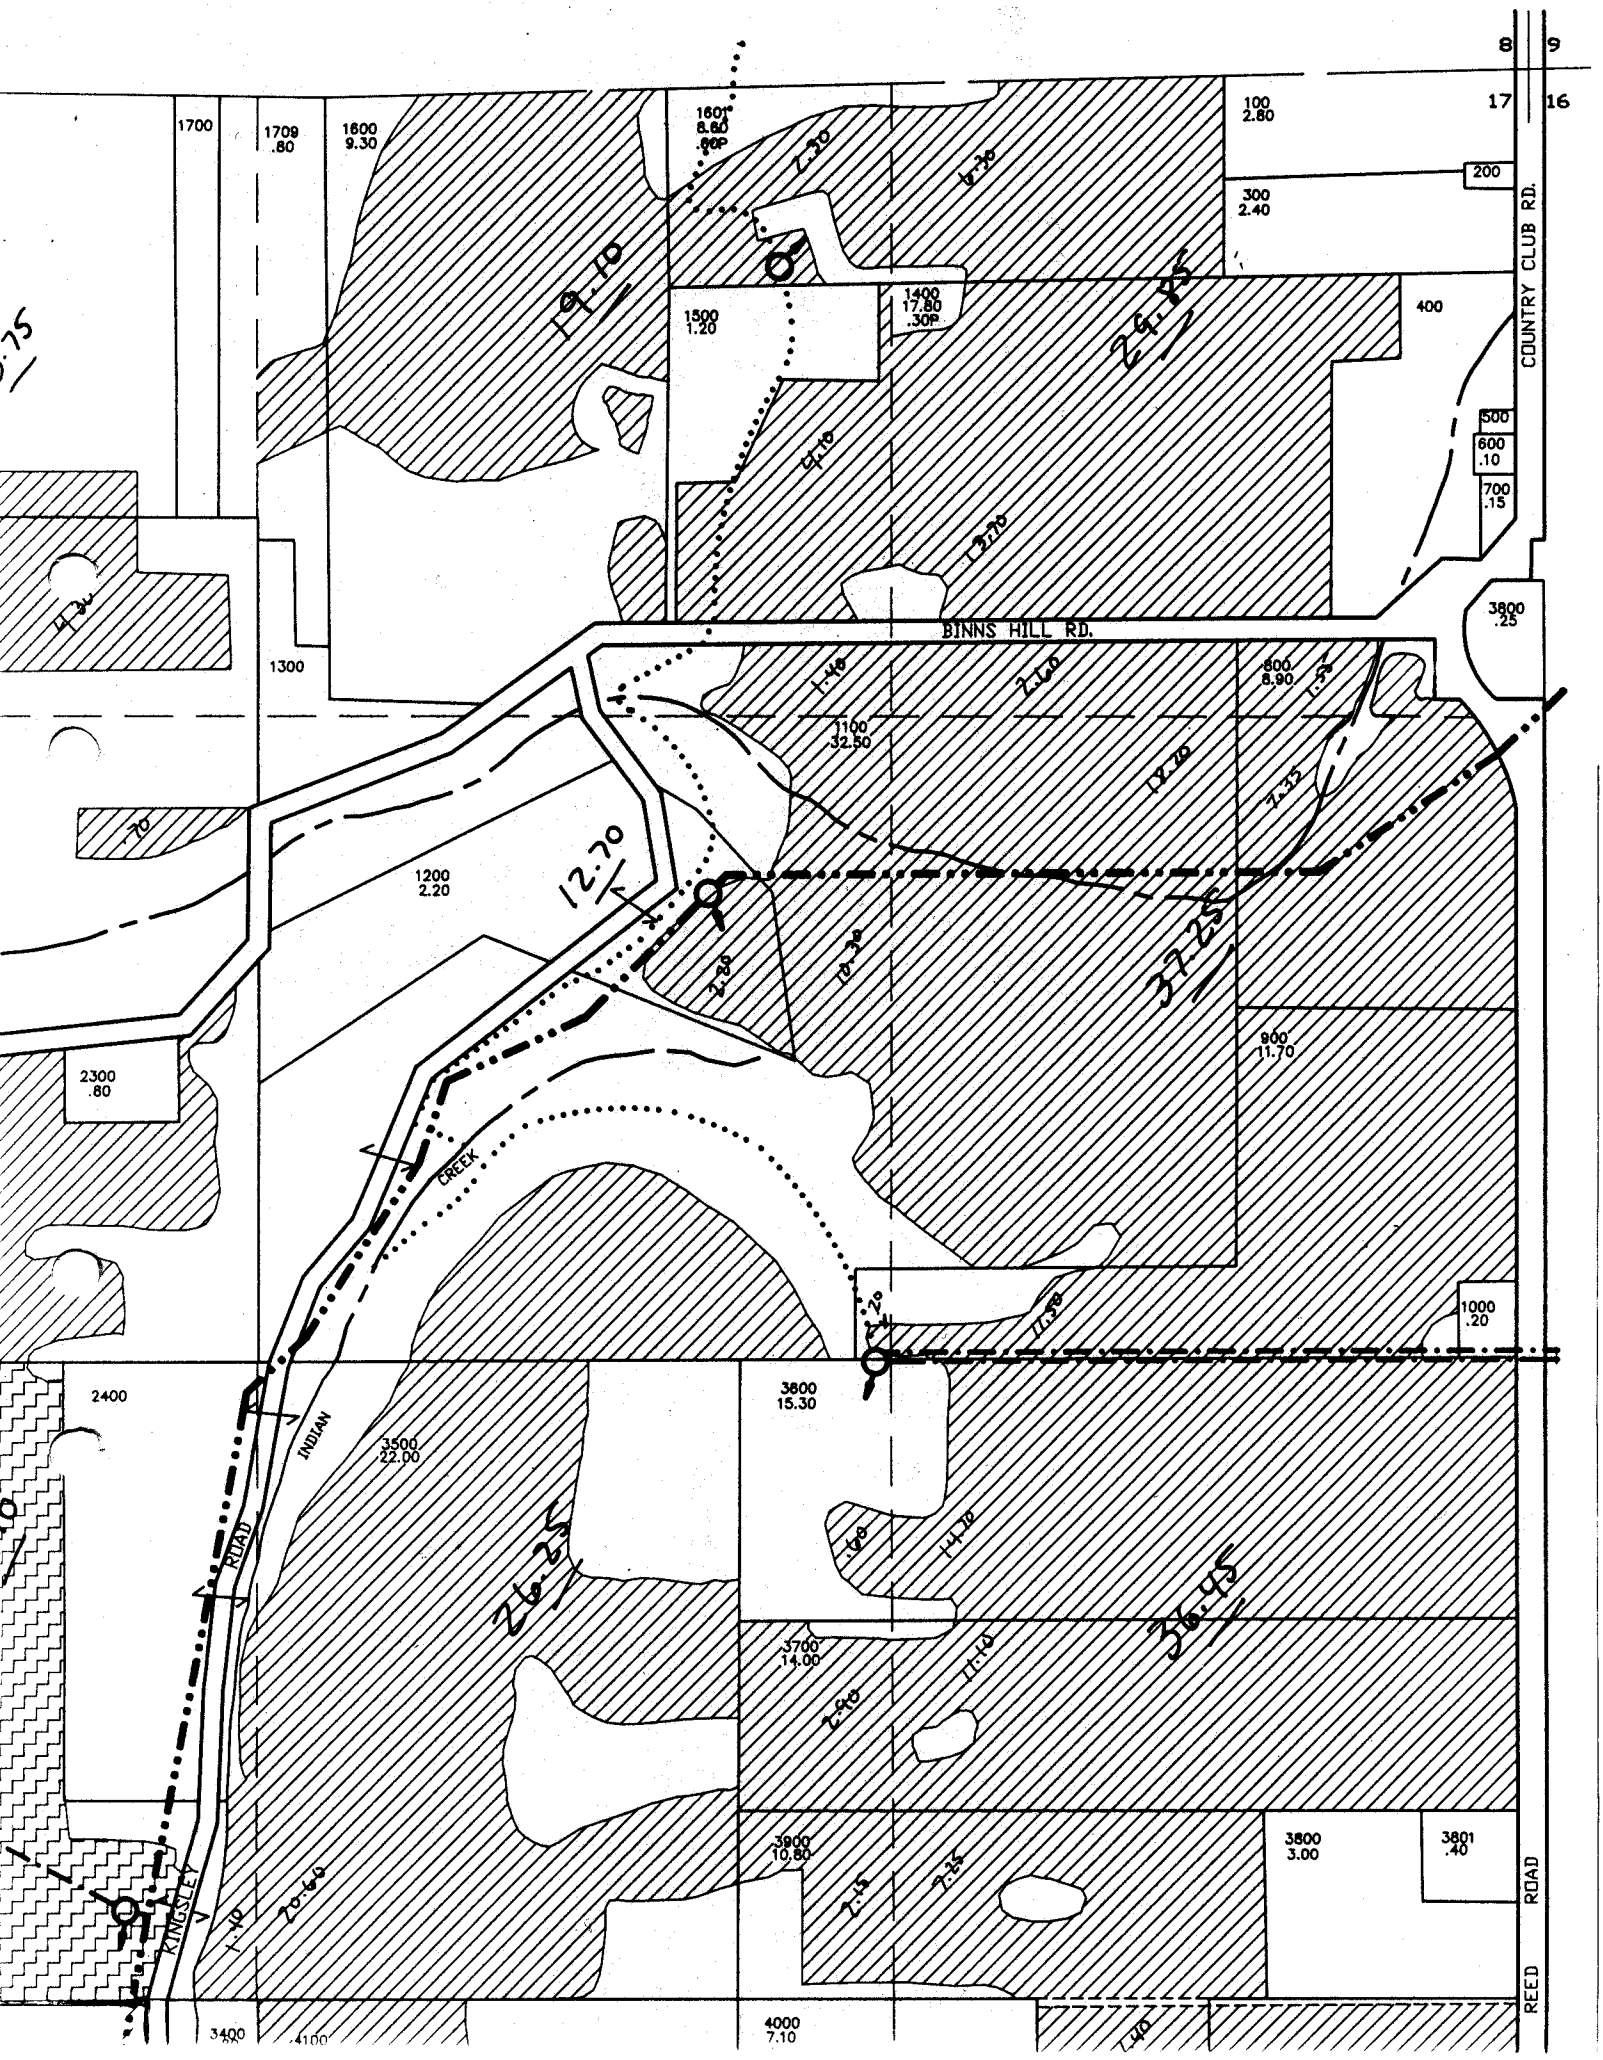
8
9
17
16
COUNTRY CLUB RD.
BINNS HILL RD.
INDIAN
CREEK
ROAD
KINGSLEY
REED
ROAD
1700
1709
.80
1600
9.30
1601
8.80
.60P
100
2.80
200
300
2.40
1400
17.80
.30P
1500
1.20
400
500
600
.10
700
.15
3800
.25
1300
1100
32.50
800
8.90
1200
2.20
900
11.70
2300
.80
1000
.20
2400
3600
15.30
3500
22.00
3700
14.00
3900
10.80
3800
3.00
3801
.40
3400
4100
4000
7.10
19.10
26.45
12.70
37.25
26.25
36.45