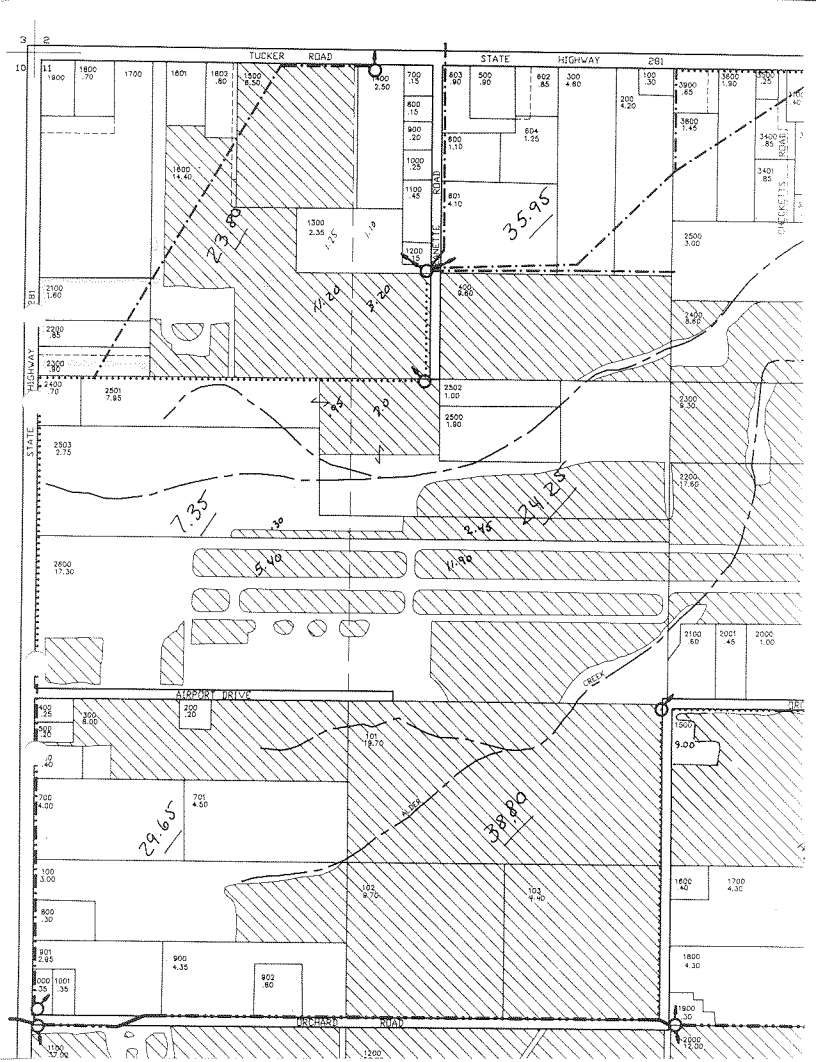
TUCKER ROAD
STATE HIGHWAY 281
ROCKETTE ROAD
STATE HIGHWAY 281
AIRPORT DRIVE
ORCHARD ROAD
CREEK
3595
2380
1120
320
705
345
1.30
2.45
5.40
11.80
7.35
2425
2965
3880
9.00