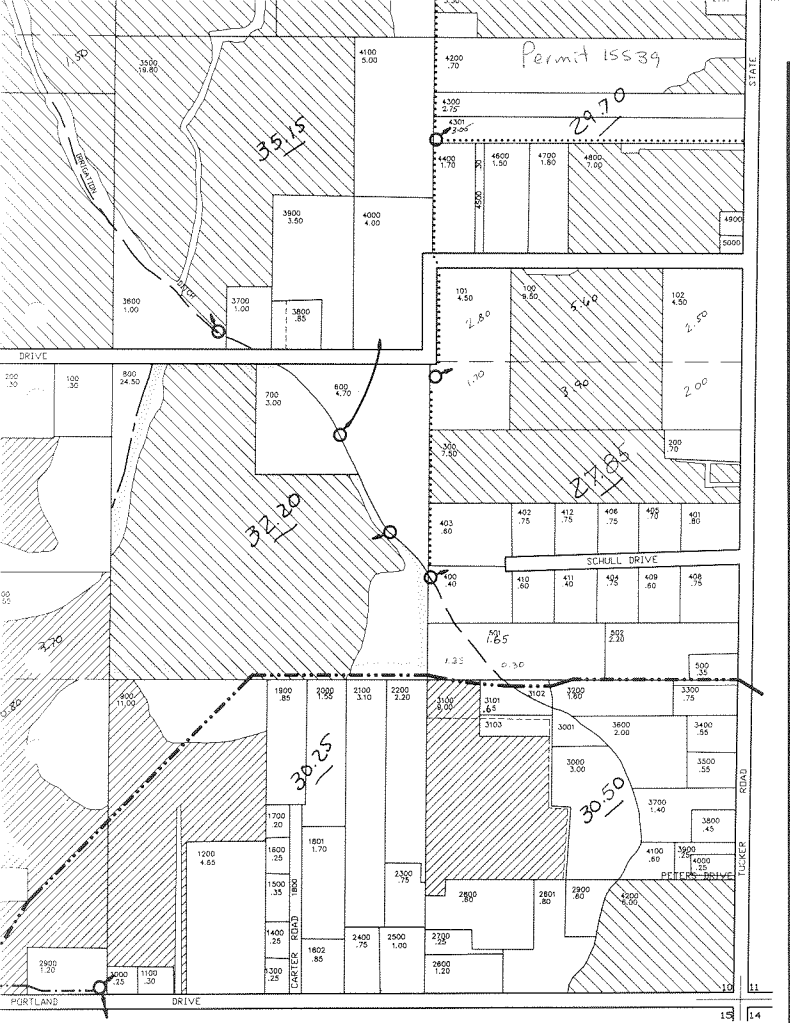
Permit 15539
29.70
35.15
27.85
30.25
30.50
DRIVE
SCHULL DRIVE
PETERS DRIVE
CARTER ROAD
TUCKER ROAD
PORTLAND DRIVE
STATE
DRIVEWAY
DITCH
10
11
13
14