Permit. 4436

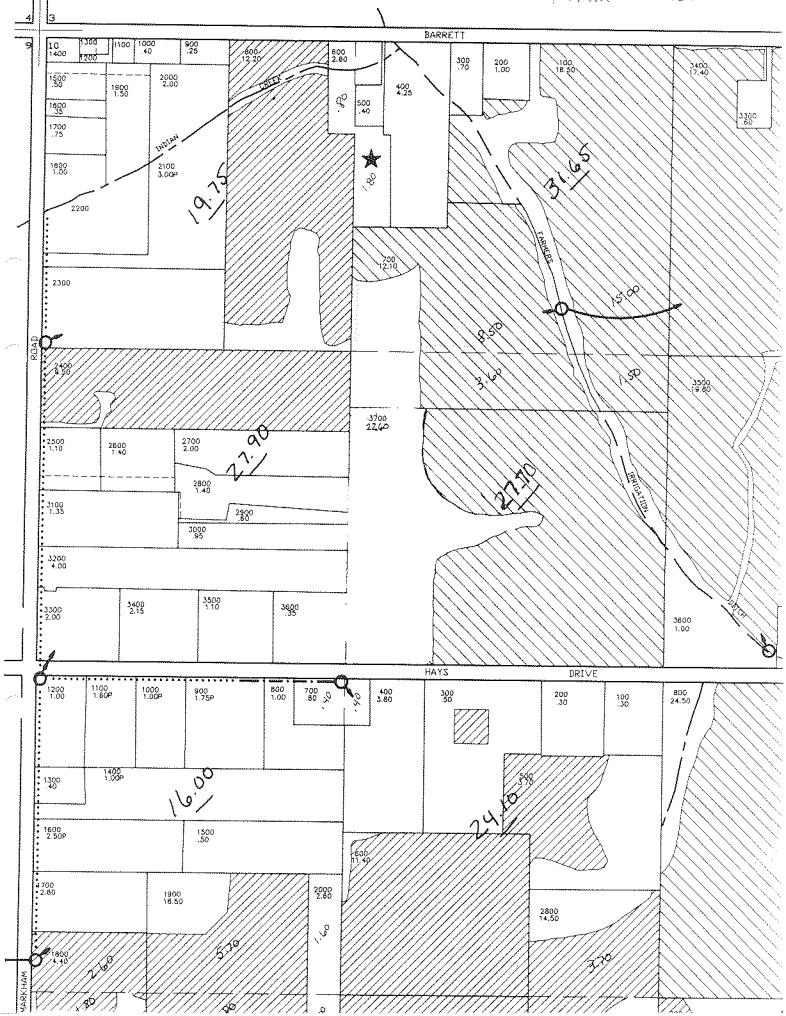
BARRETT
HAYS
DRIVE
ROAD
MARKHAM
FARMERS
DITCH
19.75
31.65
27.90
27.70
16.00
24.40
5.70
2.80
1.80