Permit 3840

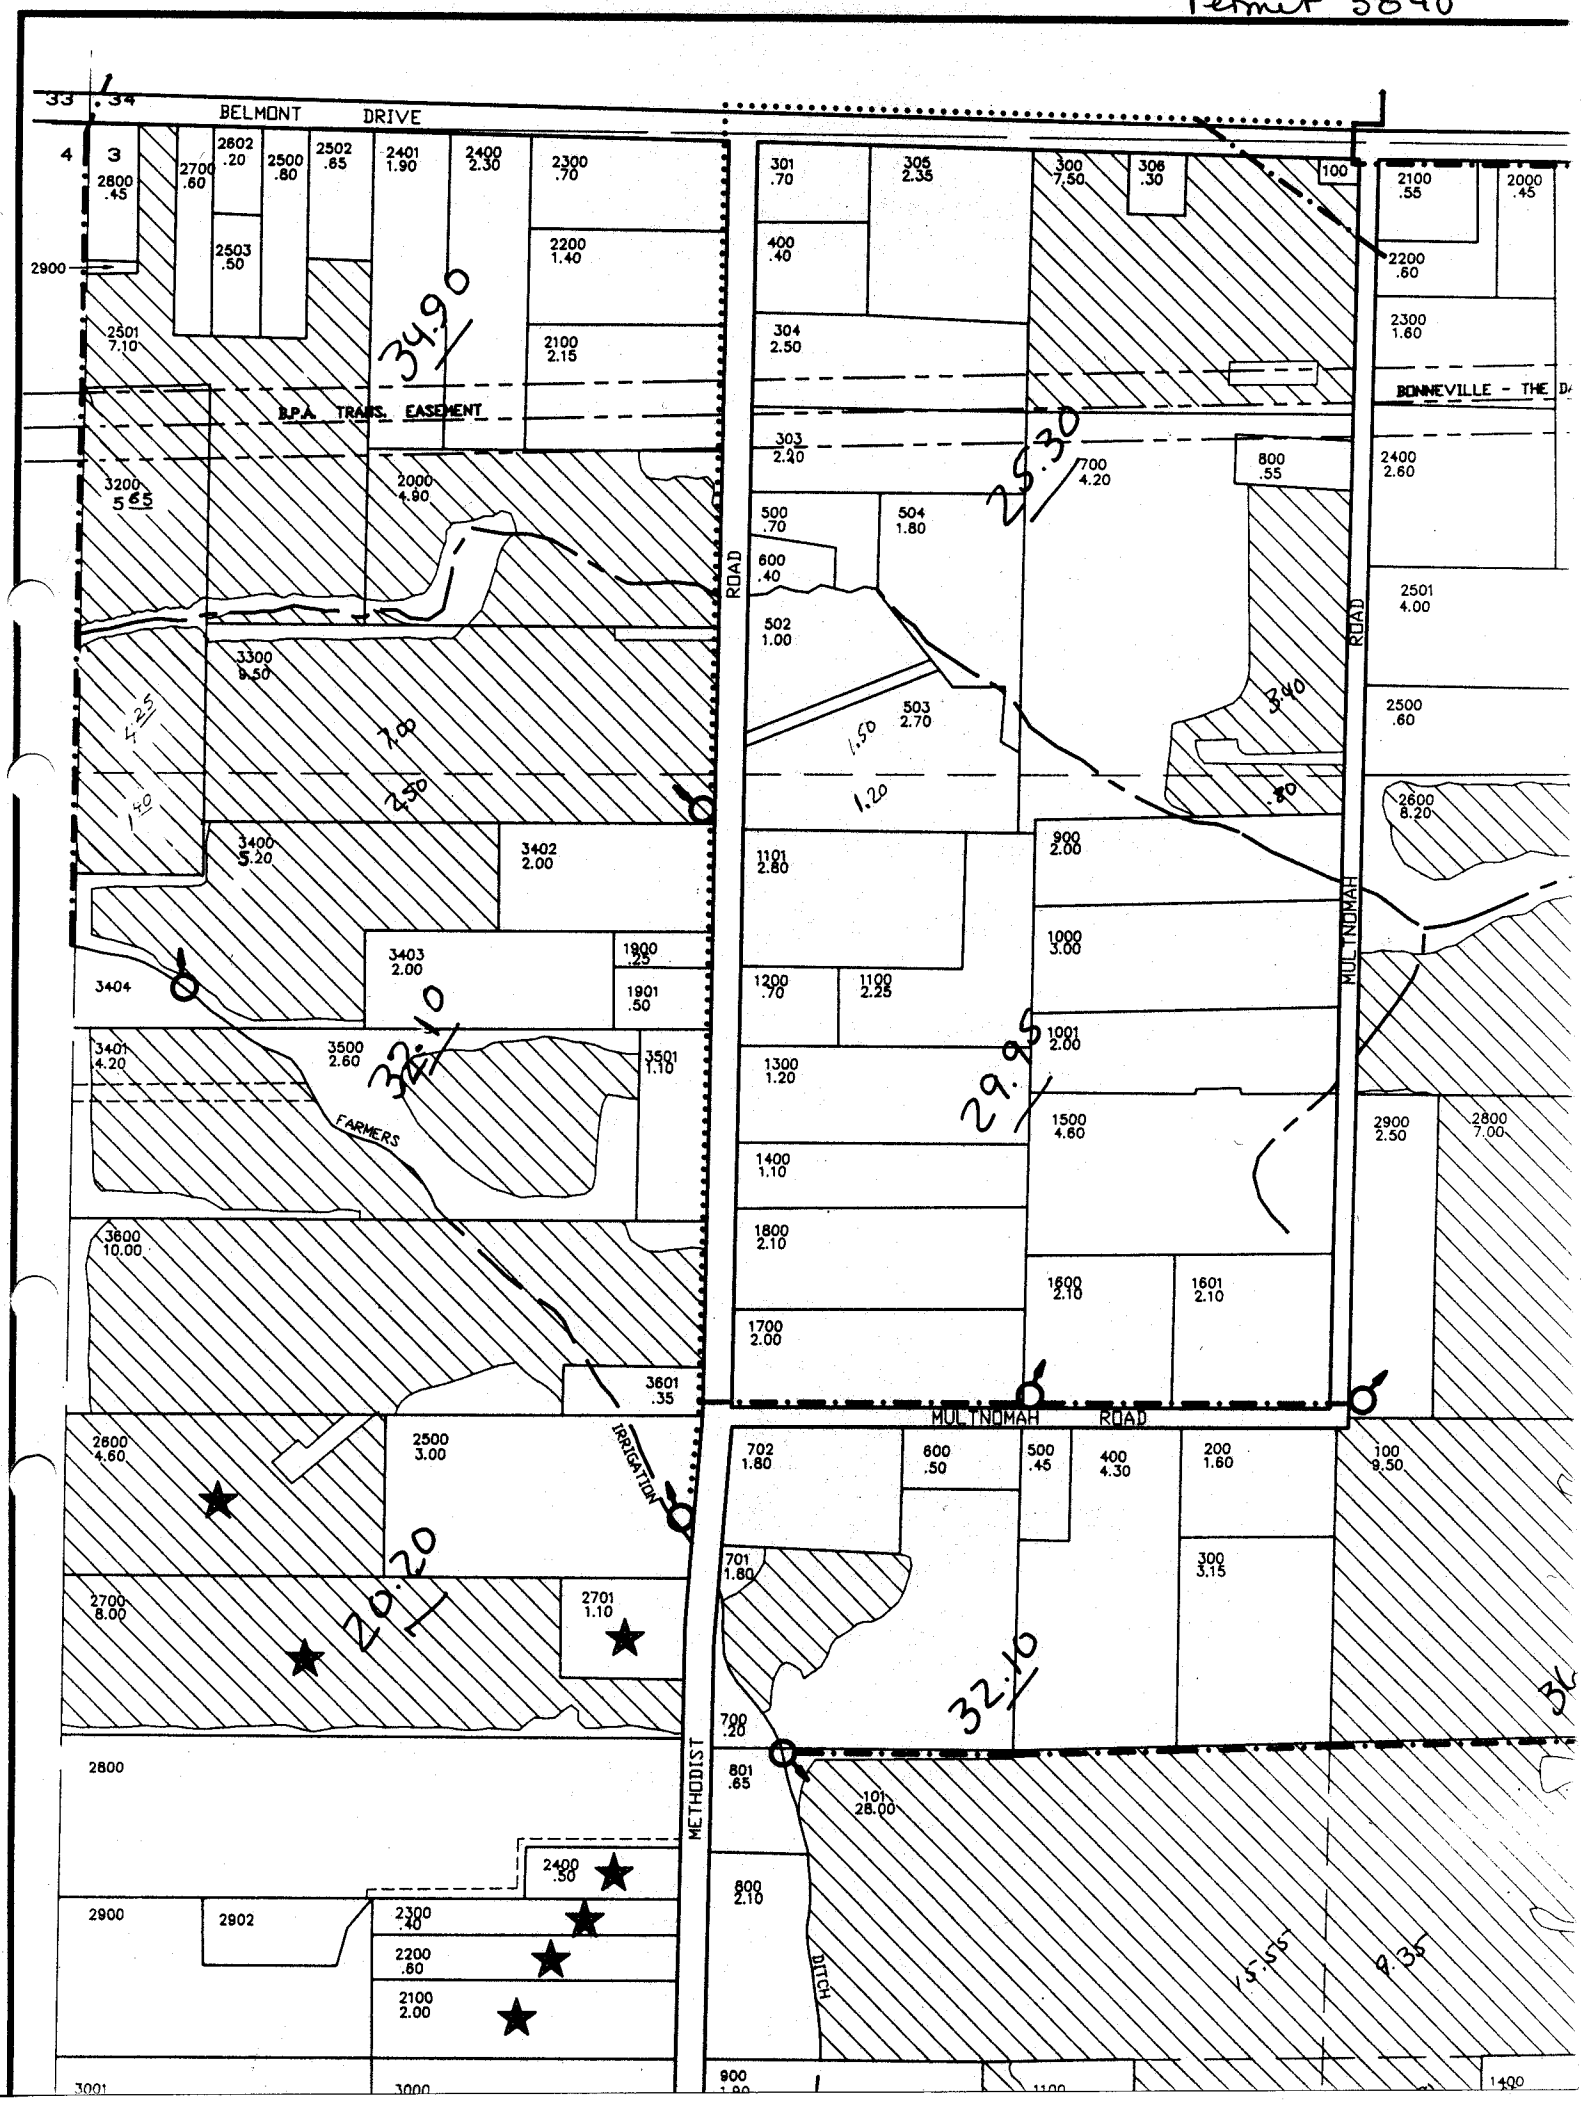
33
34
BELMONT DRIVE
4
3
2800 .45
2700 .60
2602 .20
2503 .50
2500 .80
2502 .65
2401 1.90
2400 2.30
2300 .70
2200 1.40
2100 2.15
2900
2501 7.10
34.90
B.P.A. TRANS. EASEMENT
3200 5.65
2000 4.90
3300 9.50
4.25
1.40
7.00
2.50
3400 5.20
3402 2.00
3403 2.00
1900 .25
1901 .50
3404
3401 4.20
3500 2.60
32.10
3501 1.10
FARMERS
3600 10.00
3601 .35
2600 4.60
2500 3.00
IRRIGATION
20.20
2700 8.00
2701 1.10
2800
2400 .50
2900
2902
2300 .40
2200 .60
2100 2.00
3001
3000
METHODIST
ROAD
301 .70
305 2.35
300 7.50
306 .30
100
400 .40
304 2.50
303 2.40
25.30
700 4.20
800 .55
500 .70
504 1.80
600 .40
502 1.00
503 2.70
4.50
1.20
3.40
.40
1101 2.80
900 2.00
1000 3.00
1200 .70
1100 2.25
1001 2.00
29.95
1300 1.20
1500 4.60
1400 1.10
1800 2.10
1600 2.10
1601 2.10
1700 2.00
MULTNOMAH ROAD
702 1.80
600 .50
500 .45
400 4.30
200 1.60
100 9.50
701 1.80
300 3.15
32.10
700 .20
801 .65
101 28.00
800 2.10
DITCH
15.55
9.35
2100 .55
2000 .45
2200 .60
2300 1.60
BONNEVILLE - THE D
2400 2.60
2501 4.00
2500 .60
2600 8.20
2900 2.50
2800 7.00
1400