Permit 4700

See Also Map in Map Book

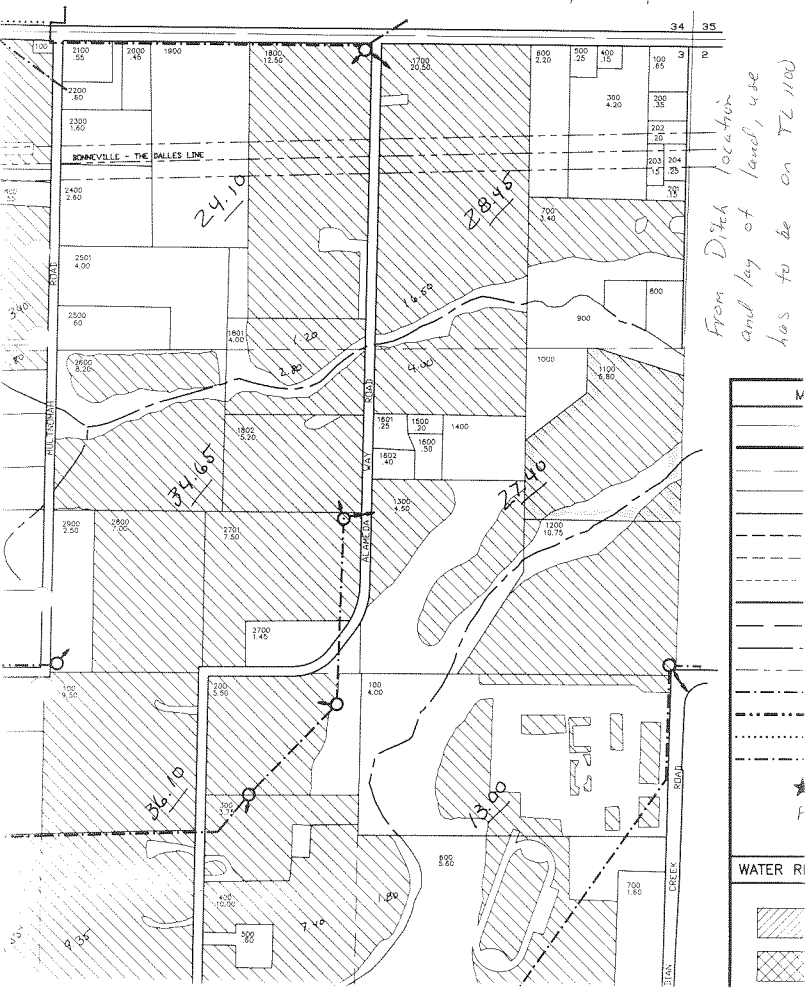

From Ditch location and lay of land, use has to be on TL 1100