
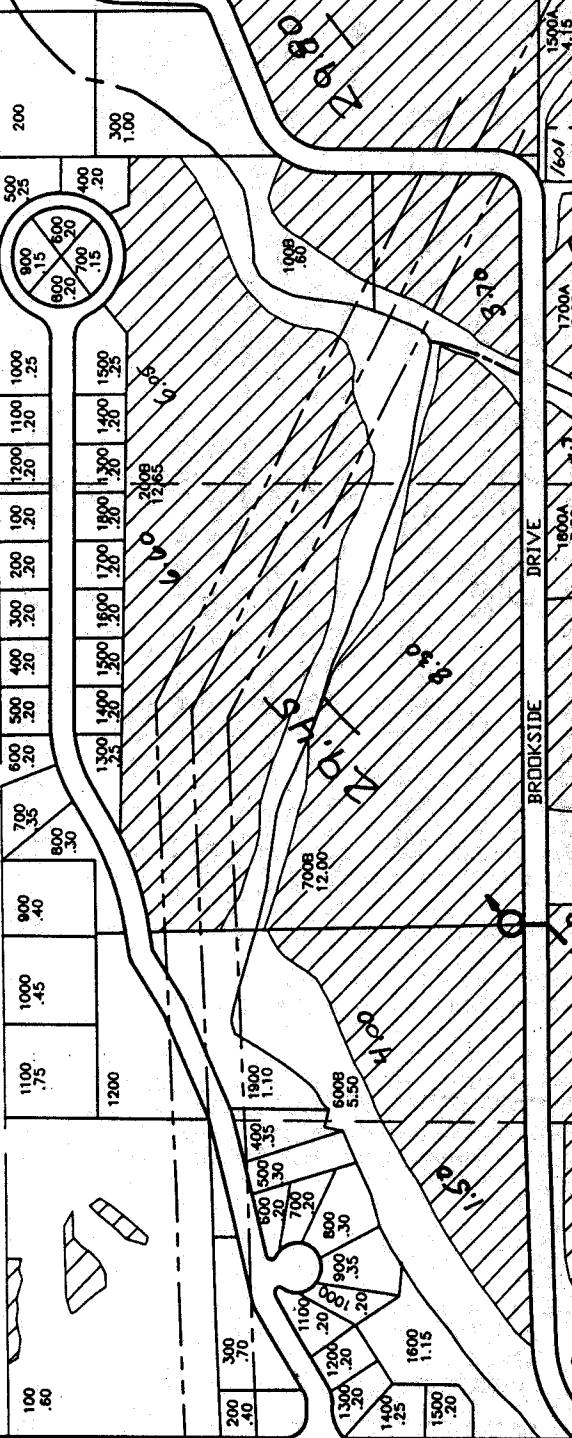


34 35

3	2000	1900	1800	1700
	.55	.45	.35	.25
	2100	2300	2400	2500
	.35	.30	.30	
	2200	2700	2600	
	.25	.25	.10	
	2800	3100	3000	
	1.70	.50	.40	
	3200			
	2.20			

11.75

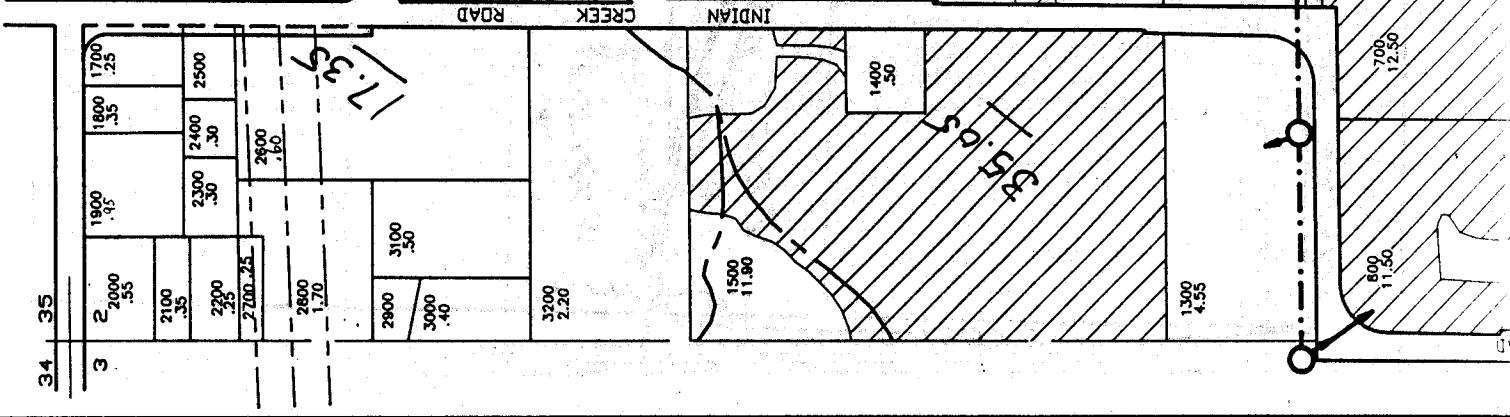

STREET NAME TAX LOT  
 Brookside 2008/1000/1400  
 Waller 400  
 Nagashima 500  
 McCoy 600/800/900  
 Walters 700  
 Gallagher 1100  
 Hosford 1500

1700	1.85
1702	.50
1600	1.90
2100	
1900	.40
2000	.25
2200	.15
2300	.30
2500	
3800	1.10
3900	1.60
3200	.15
3400	.15
3300	.15
3100	.25
3000	.15
2600	.65
2700	

