
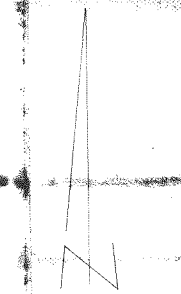


9-6803  
74372  
58062

RECEIVED  
DEC 5 1988

T. 15., R. 33E., W.M.

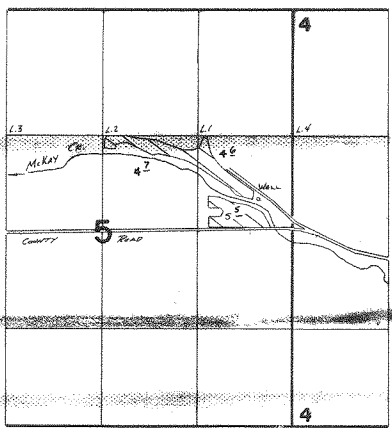

Well Loc: 2580'S ± 470'W. From NE Cor. Sec 5

**FINAL PROOF SURVEY**  
UNDER

Application No. **G:7318**, Permit No. **G:6863**  
IN NAME OF

..... **ROD THEIS** .....

Surveyed 2.75..... 1987, by H. Church.....