


T. 37 S., R. 7 W., W.M.

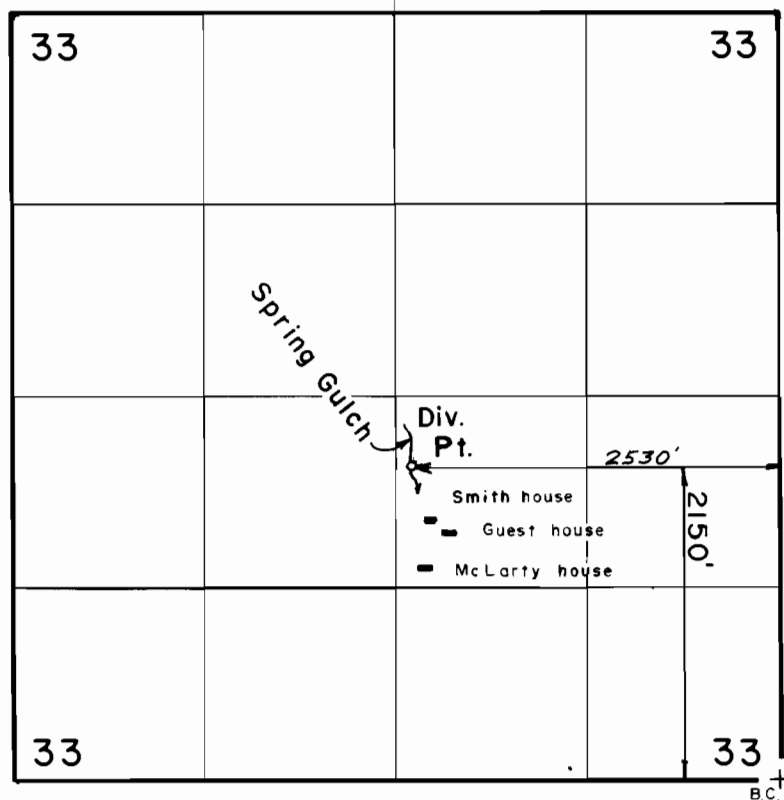

Scale: 1" = 1320'

FINAL PROOF SURVEY
UNDER

Application No. 65049 Permit No. 47790
IN NAME OF

LARRY W. SMITH / DON MC LARTY

Surveyed JUN. 19 1986, by B. S. JAMES