


FROM OFFICE OF THE

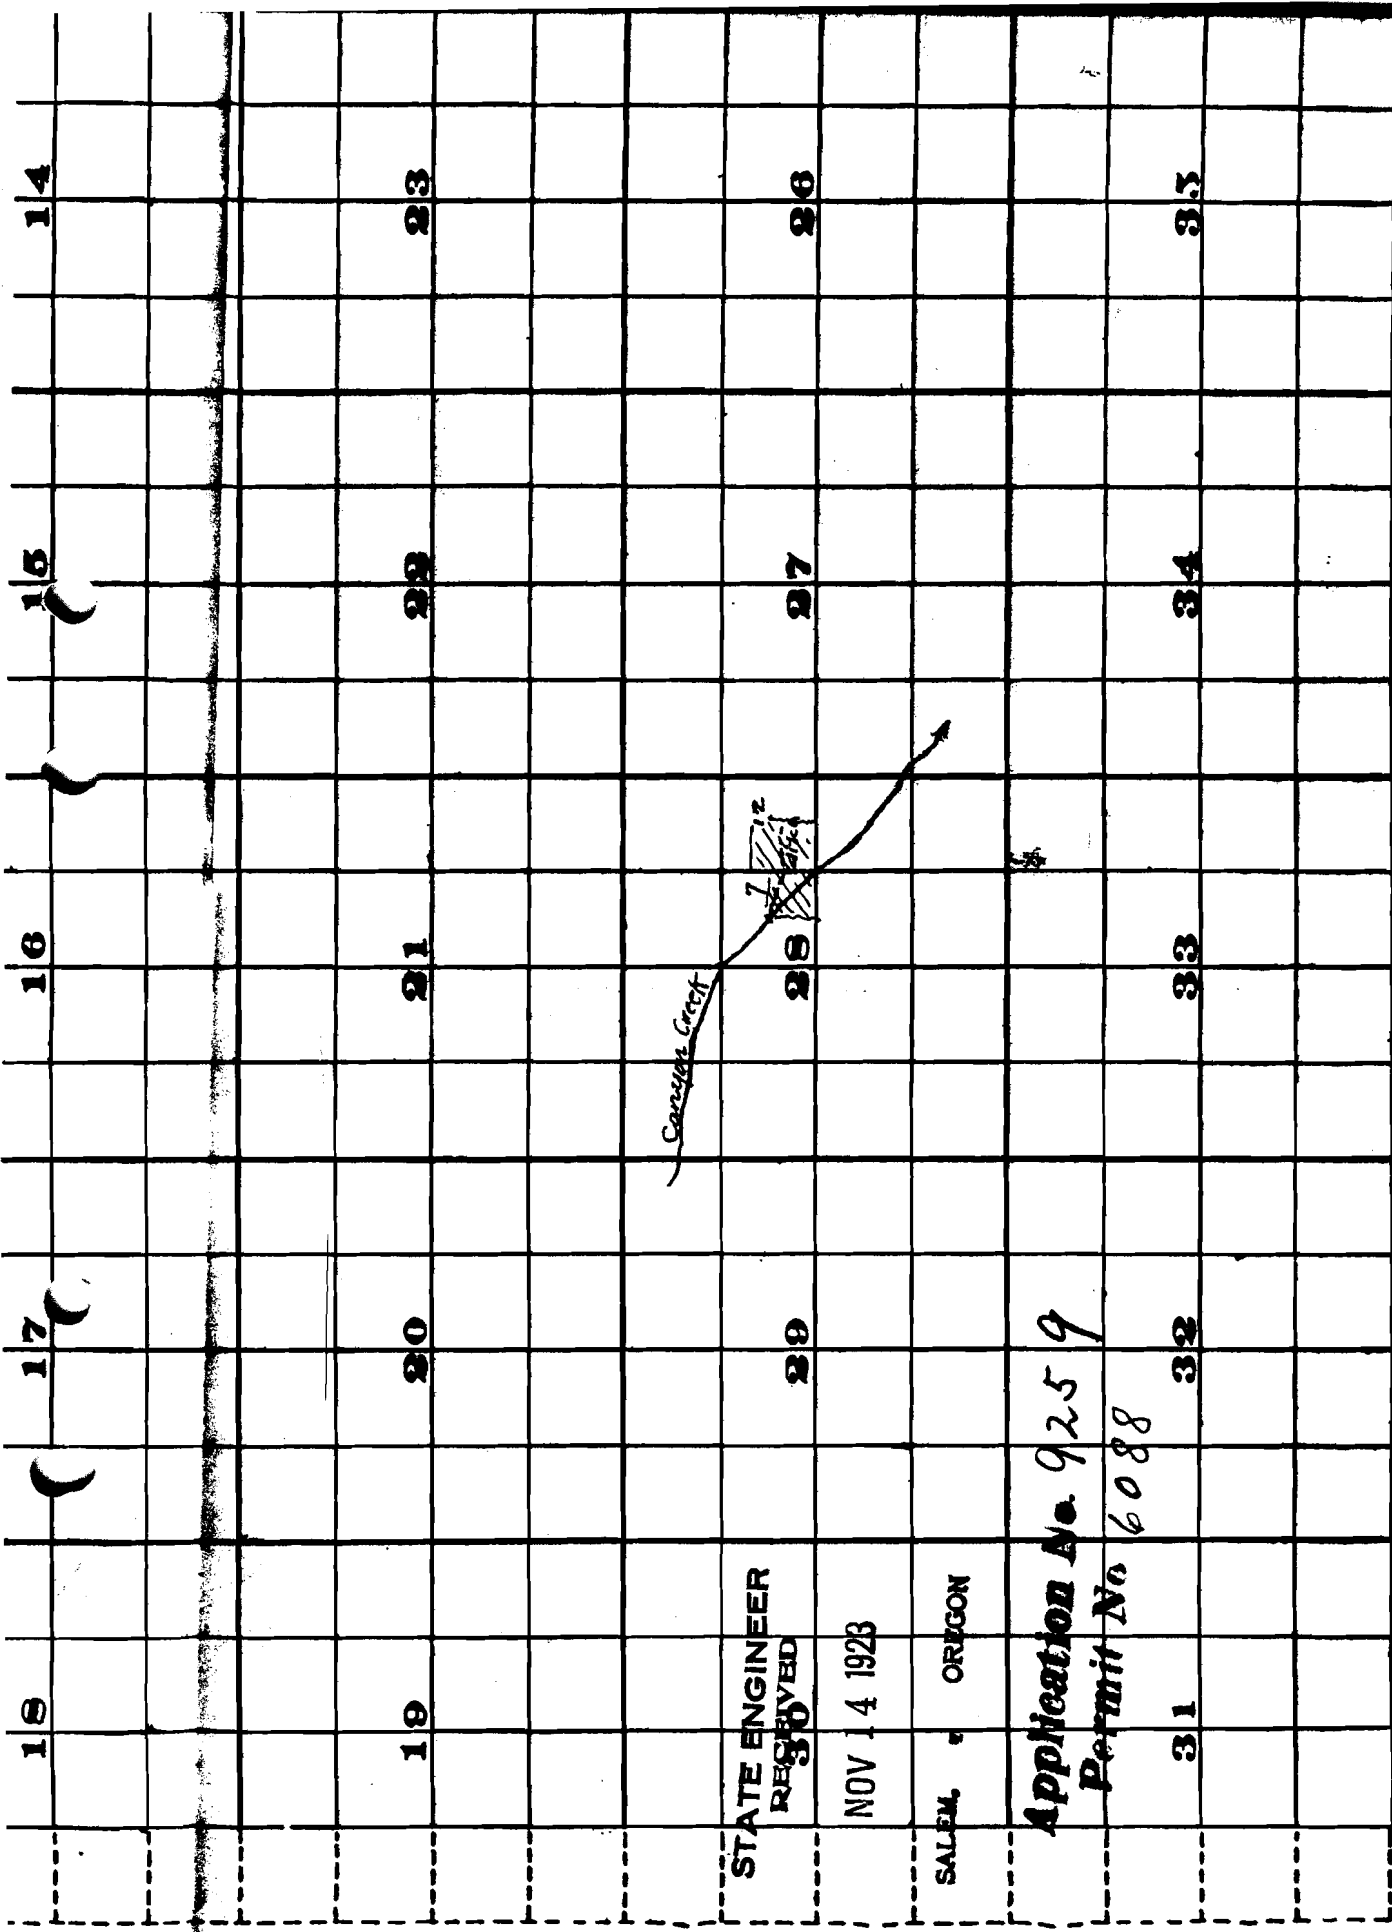

Scale of Feet.