


G-7470
T7333
65871
74443

T. 26S., R. 16E., W.M.

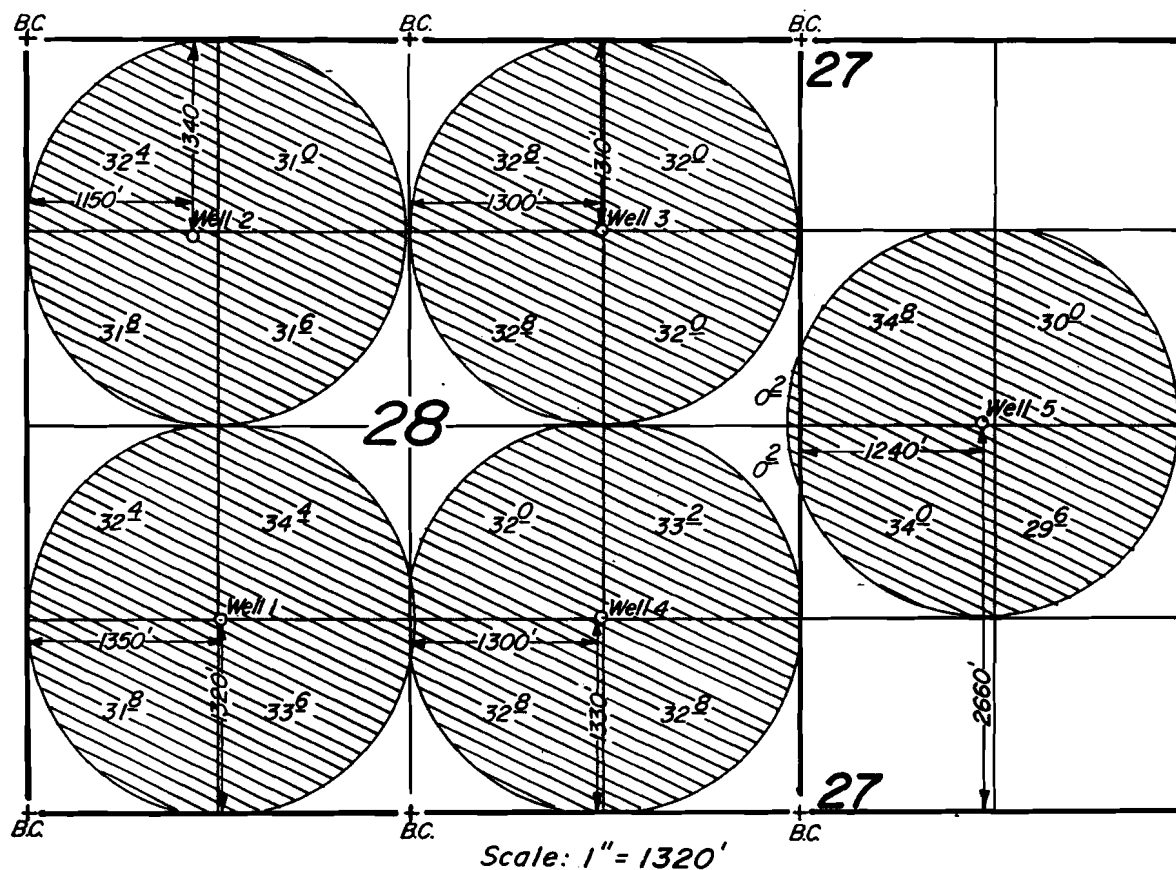

FINAL PROOF SURVEY
UNDER

Application No. G-8070. Permit No. G-7470.....

IN NAME OF

DONALD R. & ALICE G. GALLOGLY

Surveyed Oct. 13, 1985, by T. Warren.....