


6204

H PEP

Range 11 East W. M.

2 North

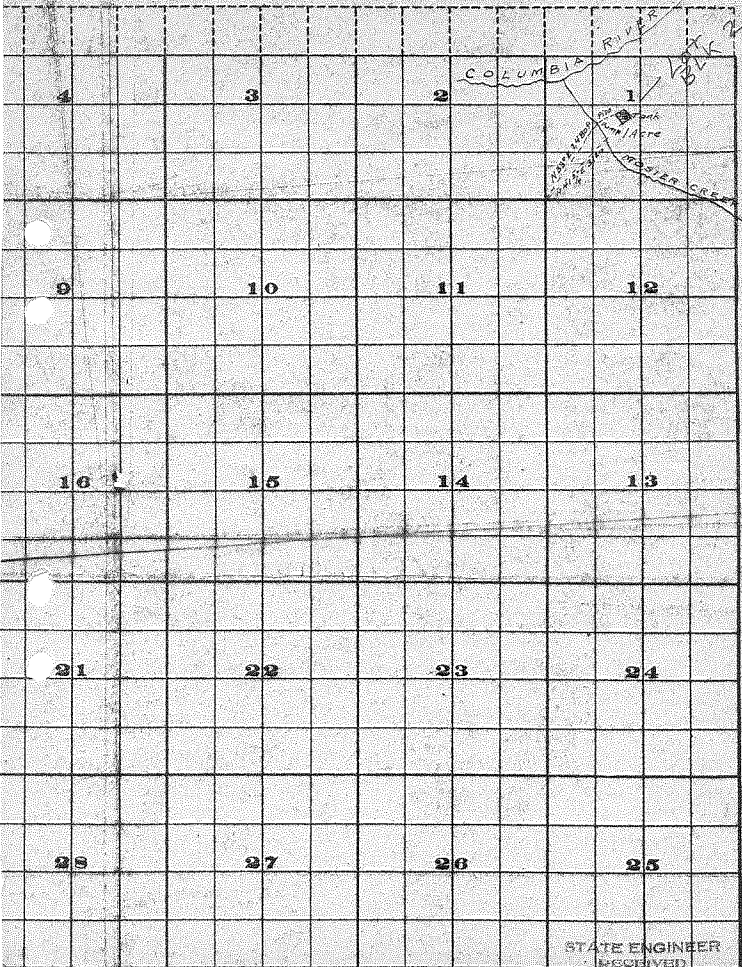

STATE ENGINEER RECEIVED