


UNITED STATES
DEPARTMENT OF THE INTERIOR
BUREAU OF LAND MANAGEMENT

SECTION
19
SW + SE +

Oregon State Water Filings
TOWNSHIP 37 S., RANGE 48 E., W. M.

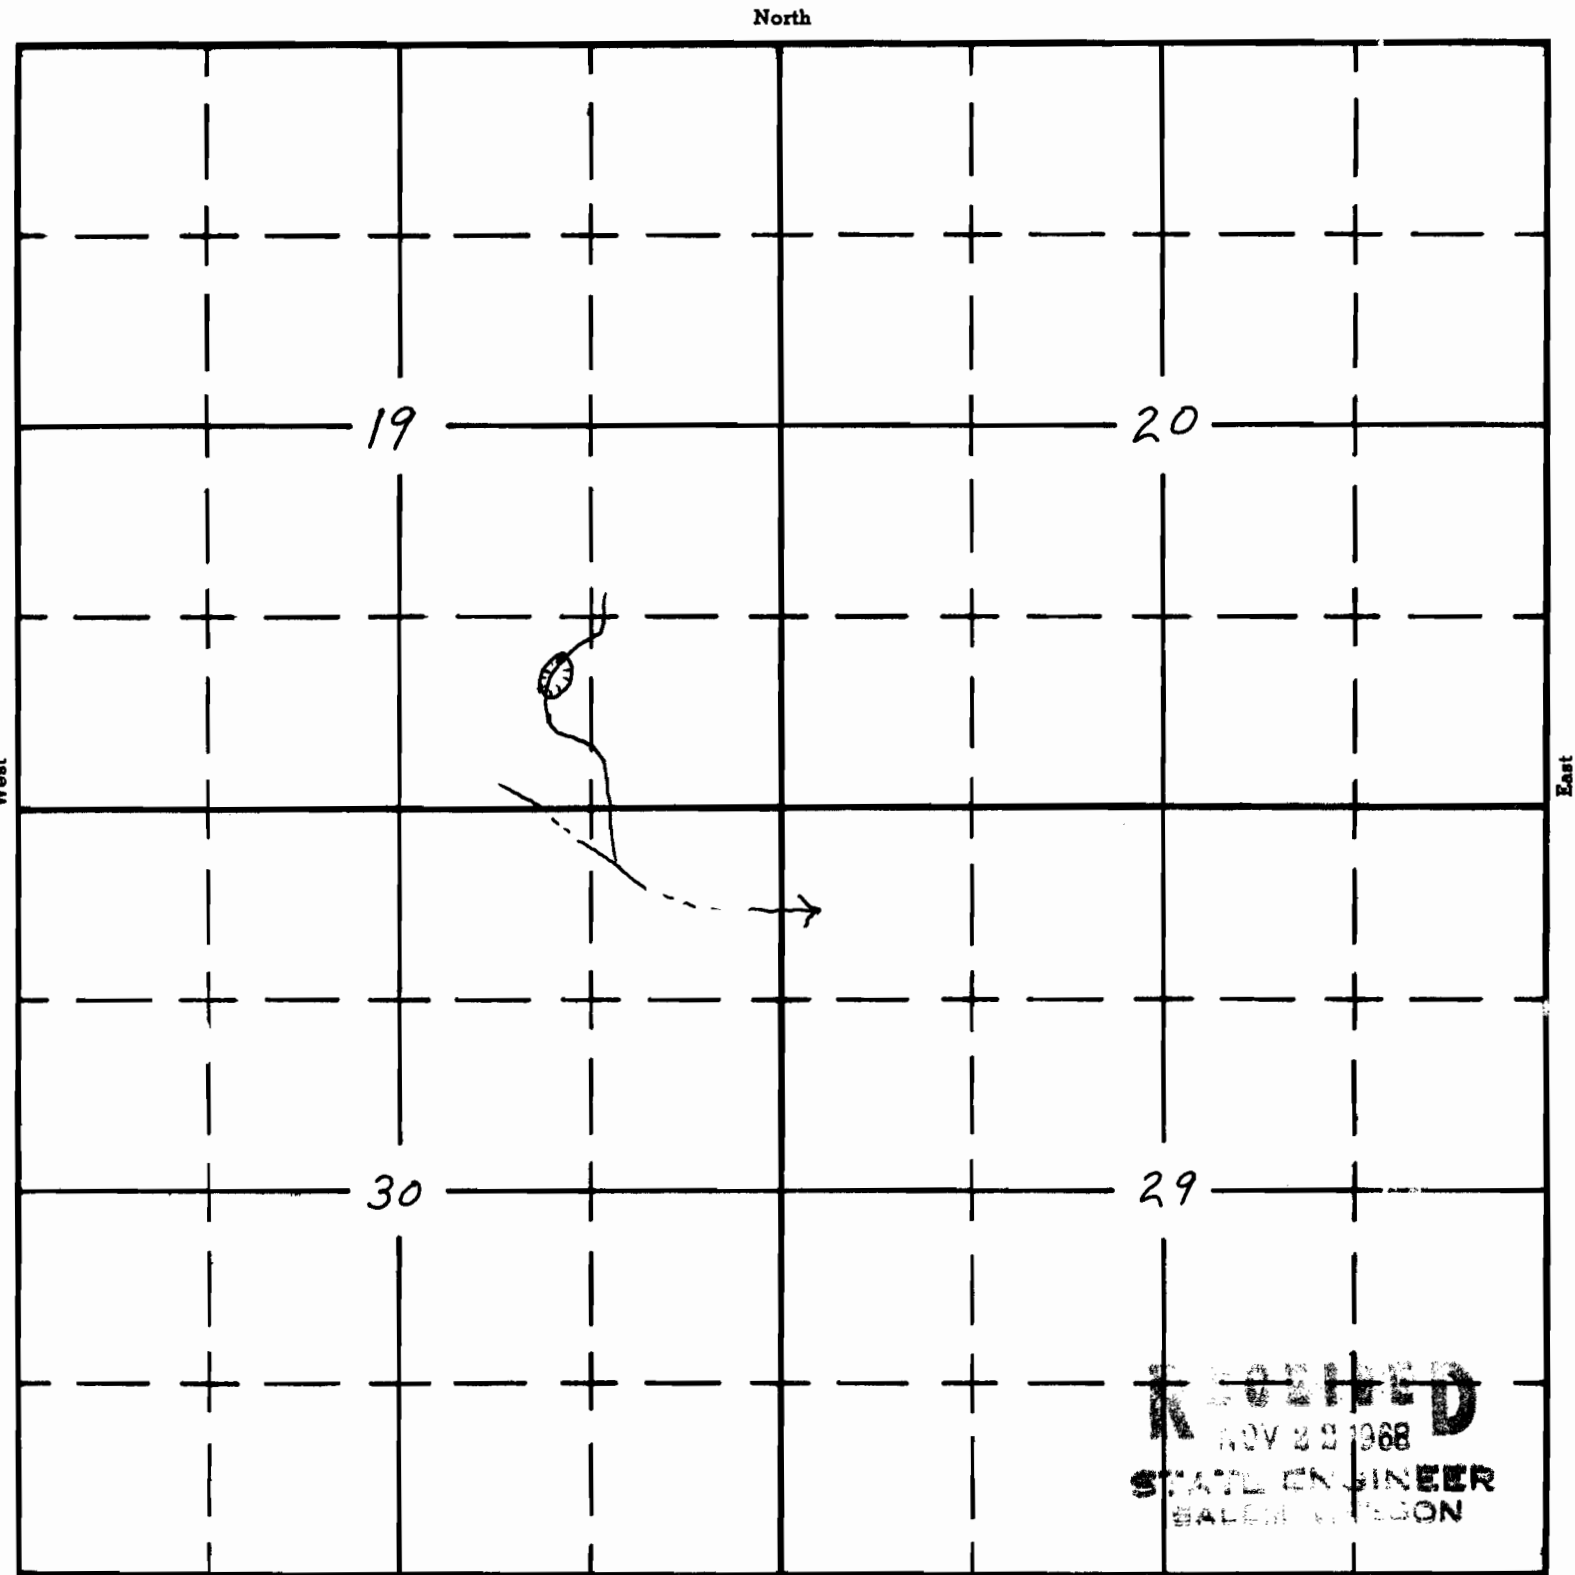

South Topp Butte Pit

RECEIVED
NOV 22 1968
STATE ENGINEER
SALEM, OREGON

APPLICATION No. R-45590
PERMIT No. **7469**