


Form AI-187
March 1961

UNITED STATES
DEPARTMENT OF THE INTERIOR
BUREAU OF LAND MANAGEMENT

SECTION _____

Oregon State Water Filings

TOWNSHIP 34 S, RANGE 4 SE, W. M.

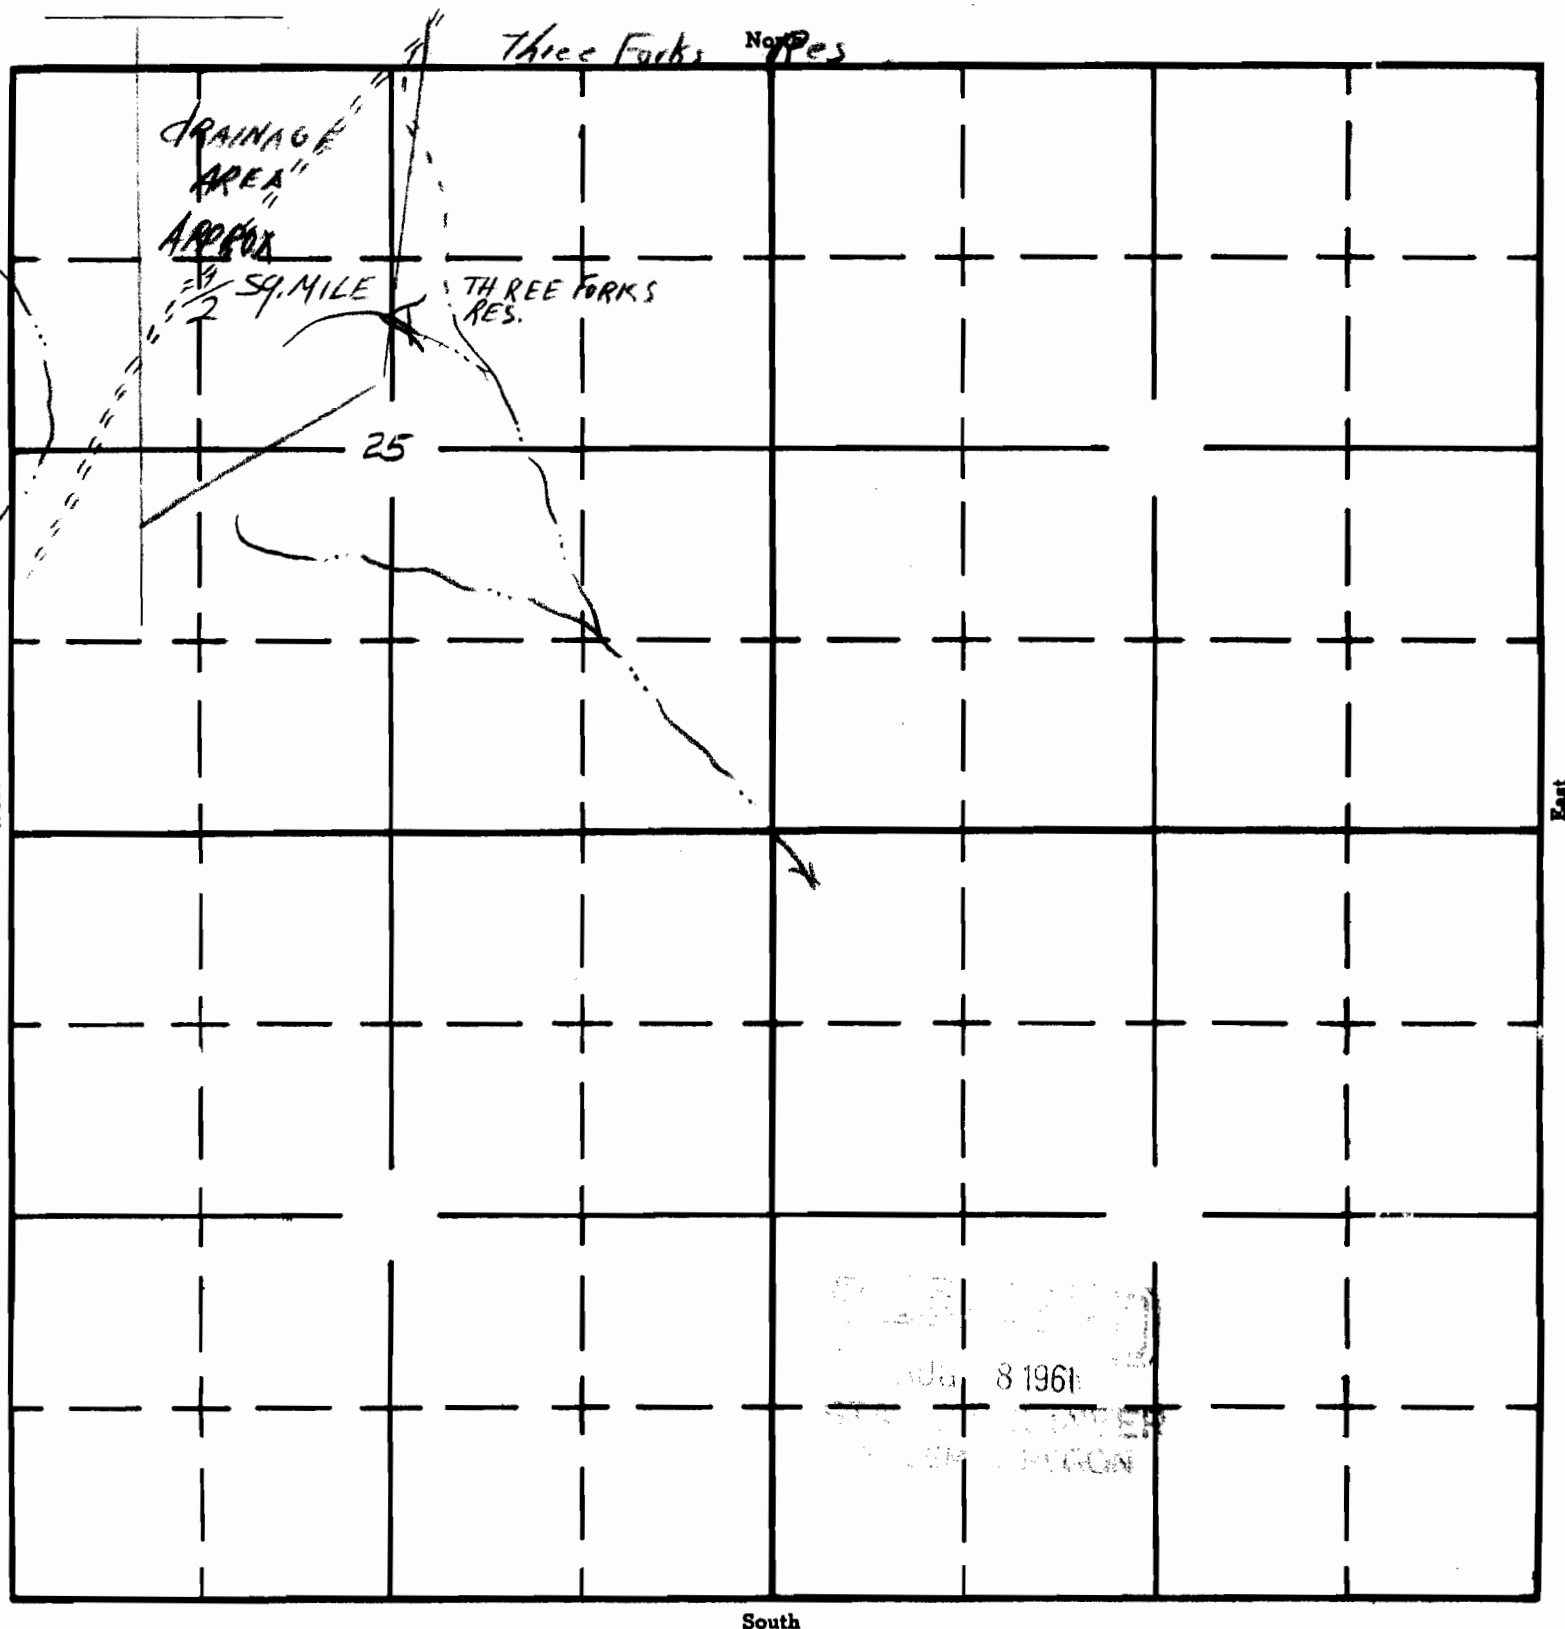

APPLICATION No. R-36642

PERMIT No. R-3649