

UNITED STATES
DEPARTMENT OF THE INTERIOR
BUREAU OF LAND MANAGEMENT


SECTION

S30

Oregon State Water Filings

TOWNSHIP 32 S, RANGE 45 E W. M.

North

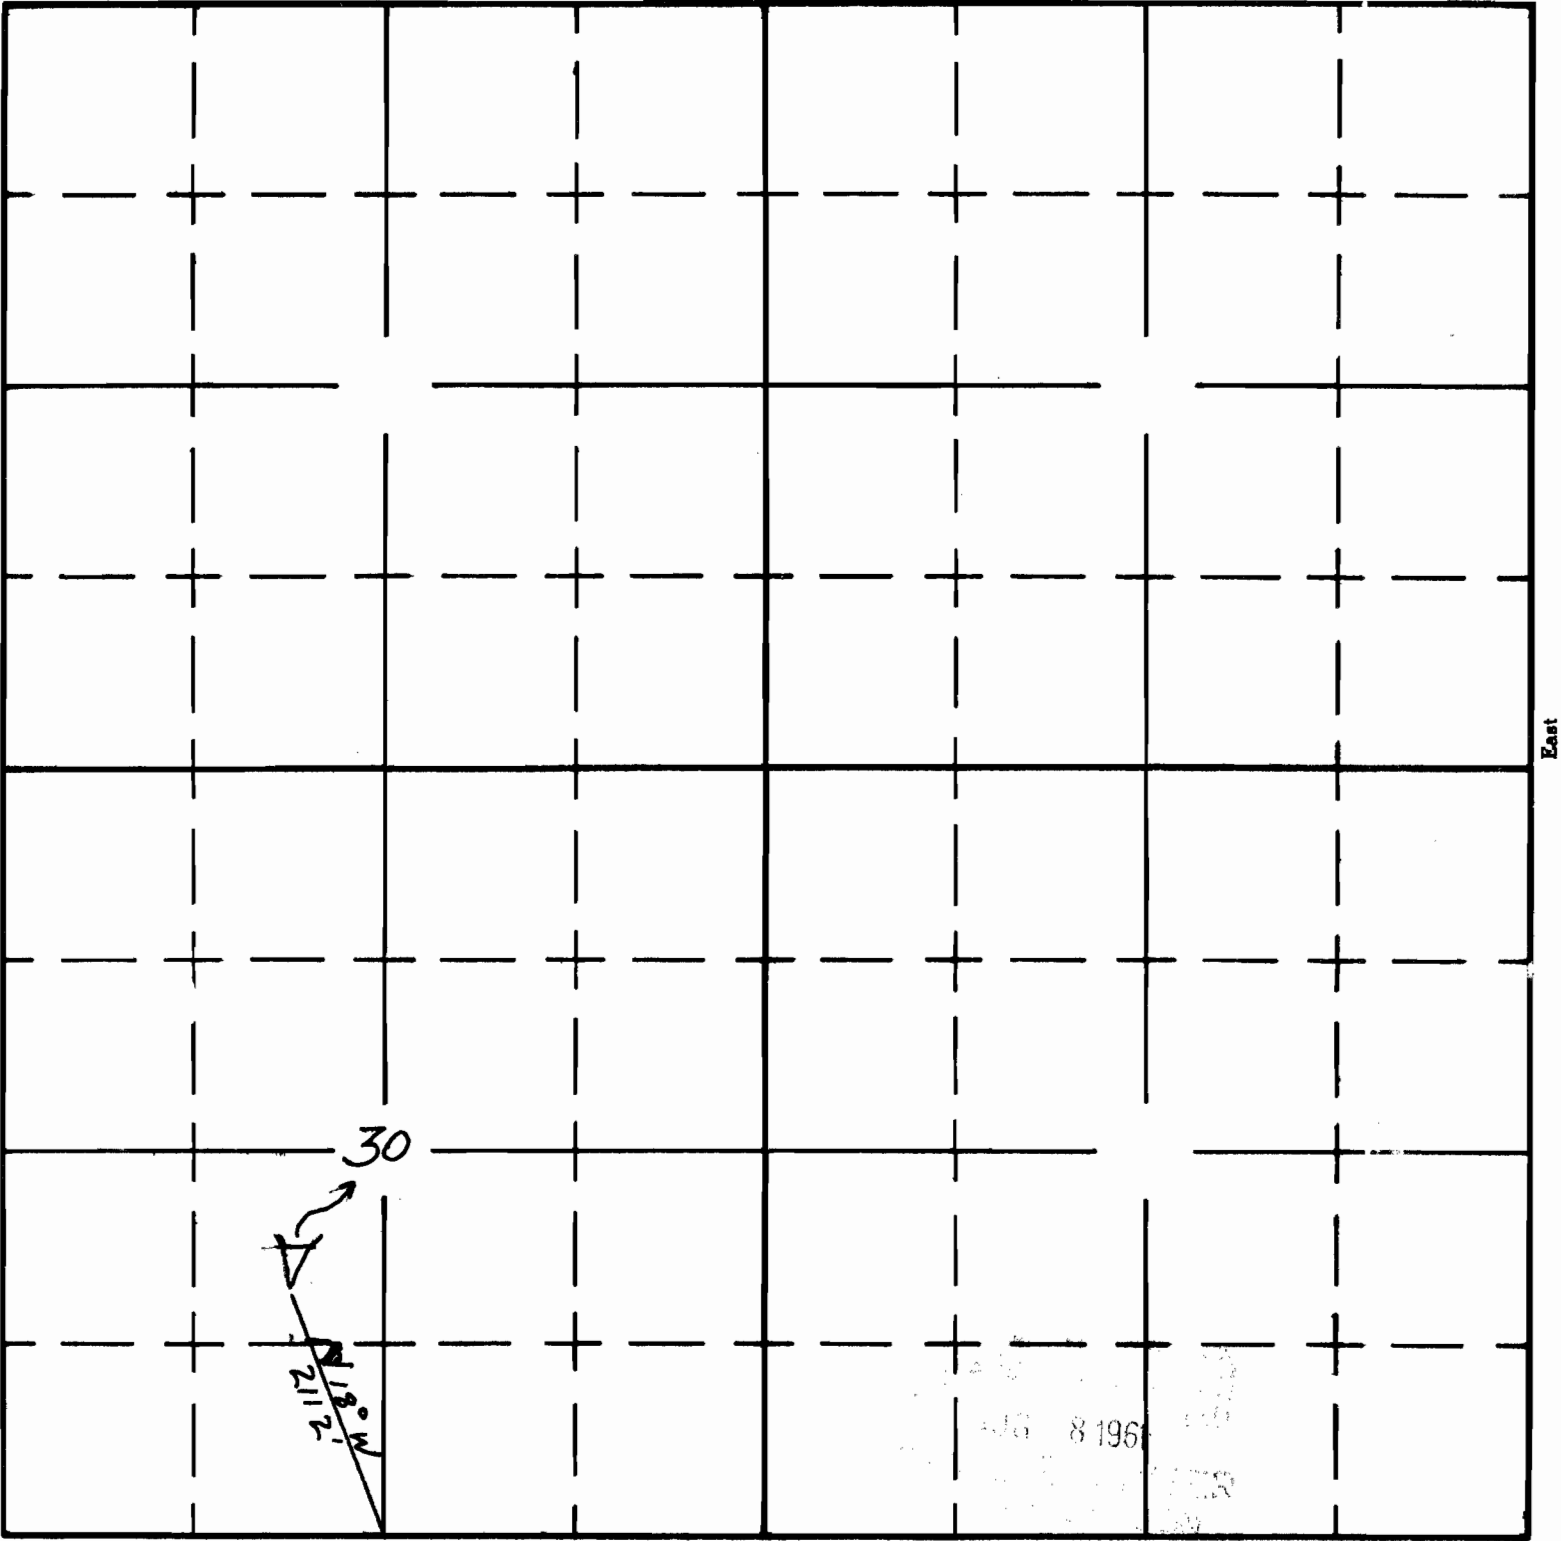

South