


T. 7 S. R. 38 E. W. M.

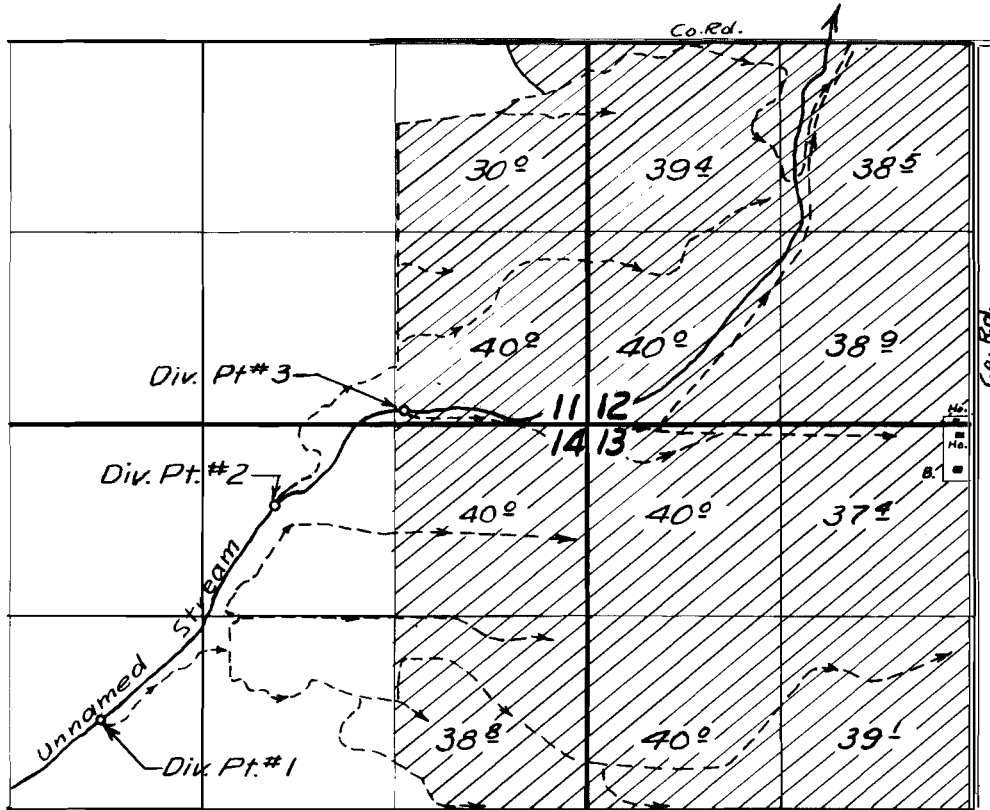

FINAL PROOF SURVEY

UNDER

Application No. 24466 Permit No. 19907

IN NAME OF

Clara M. Welch, Roy Welch, Roy Welch & Emma B. Fisher

Surveyed 27 May 1956, by J. M. Bish