

FINAL PROOF SURVEY

T 24 S, R 7 W, W M

SECTION 15

PERMITEE: FRANCIS J. & HELEN LOCHNER

21121 TYEE ROAD
OAKLAND, OREGON 97462

CWRE: JAMES D. ARTMAN

PO BOX 576
WINSTON, OREGON
(503) 679-7176



97496

APPLICATION NO. ~~50930~~ 70049
PERMIT NO. 50930

RECEIVED

MAY 17 1988

WATER RESOURCES DEPT.
SALMON DIVISION

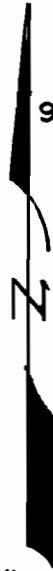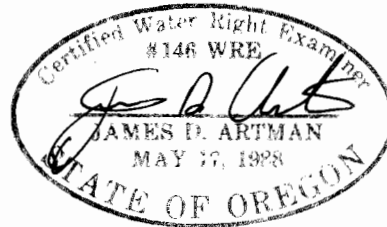

THIS MAP IS FOR WATER RIGHTS LOCATION ONLY AND DOES NOT REPRESENT PROPERTY OWNERSHIP.

SCALE 1" = 400'
MAY 18, 1990

