

UNITED STATES
DEPARTMENT OF THE INTERIOR
BUREAU OF LAND MANAGEMENT

SECTION


Oregon State Water Filings

SE $\frac{1}{4}$ NW $\frac{1}{4}$

TOWNSHIP 40S, RANGE 37E, W. M.

Sec. 15

North

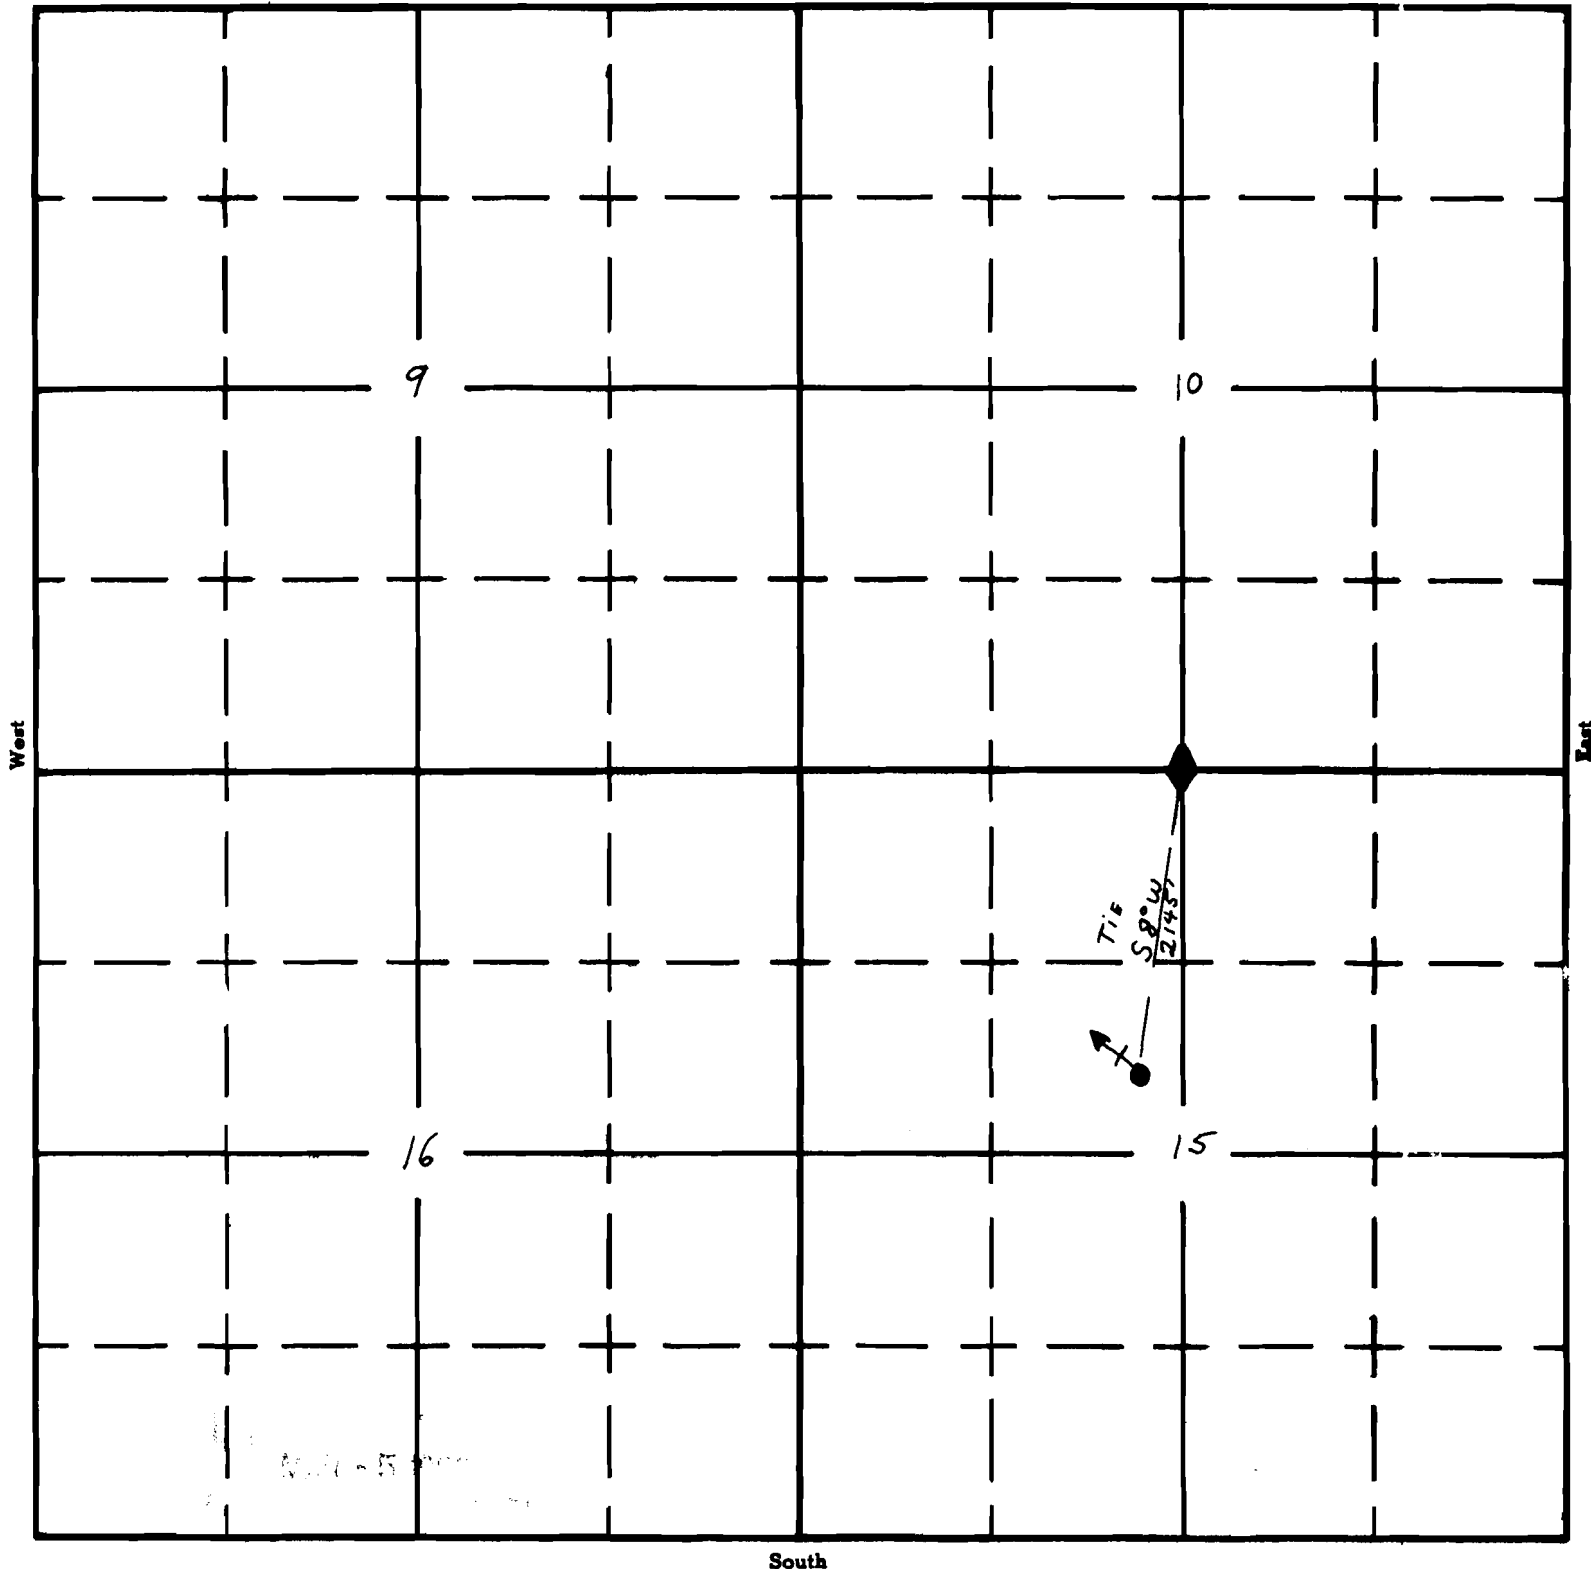

South

APPLICATION No. 35701
PERMIT No. 29331