

UNITED STATES
DEPARTMENT OF THE INTERIOR
BUREAU OF LAND MANAGEMENT

SECTION


Oregon State Water Filings

NW 1/4 SW 1/4

TOWNSHIP 41S, RANGE 37E, W. M.

Sec. 1

North

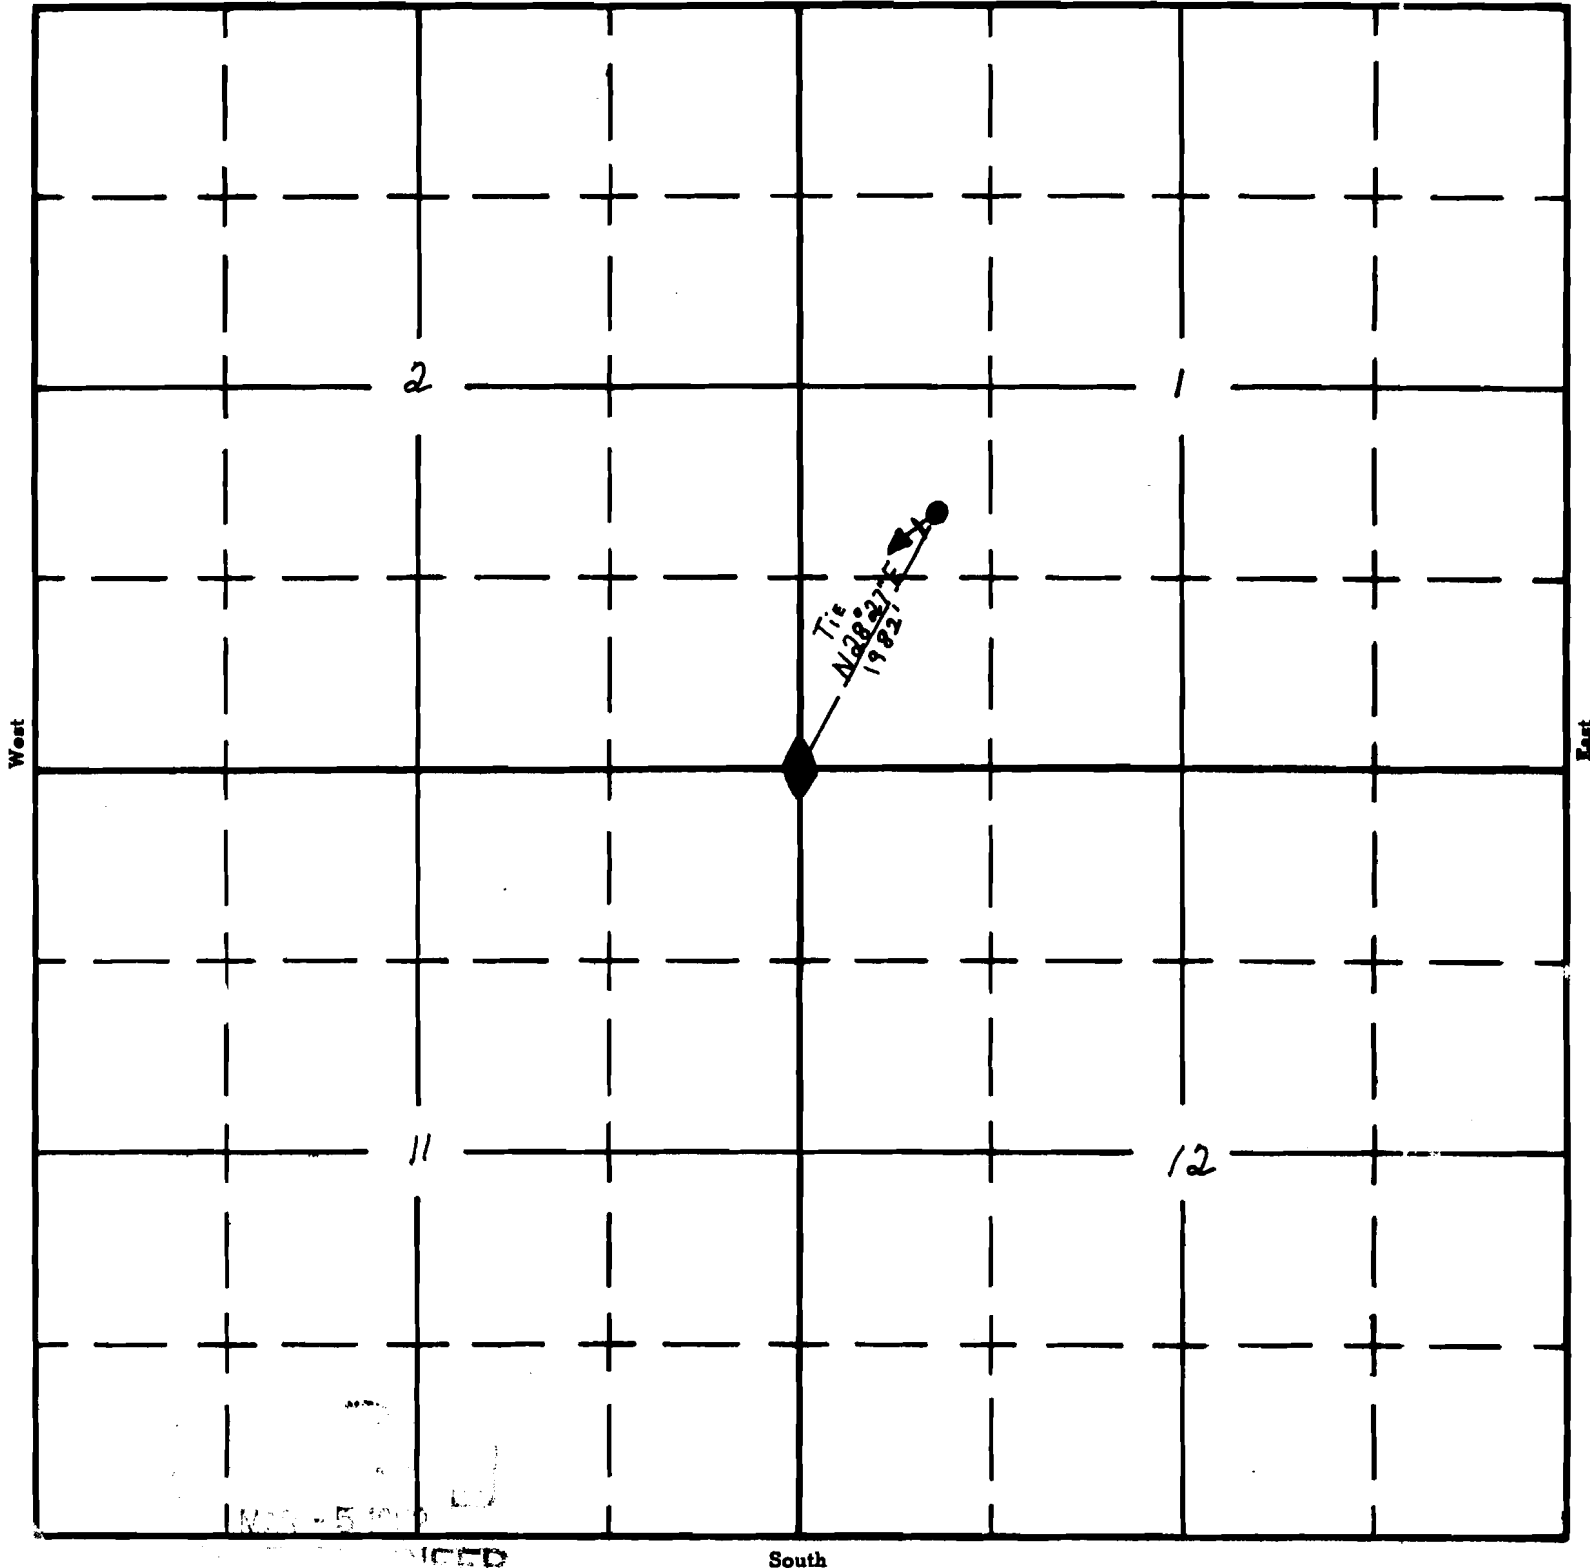

APPLICATION No. 35703
PERMIT No. 29333