

UNITED STATES
DEPARTMENT OF THE INTERIOR
BUREAU OF LAND MANAGEMENT

SECTION


SE 1/4 NE 1/4

SEC 1

Oregon State Water Filings

TOWNSHIP 41 S, RANGE 31 E, W. M.

North

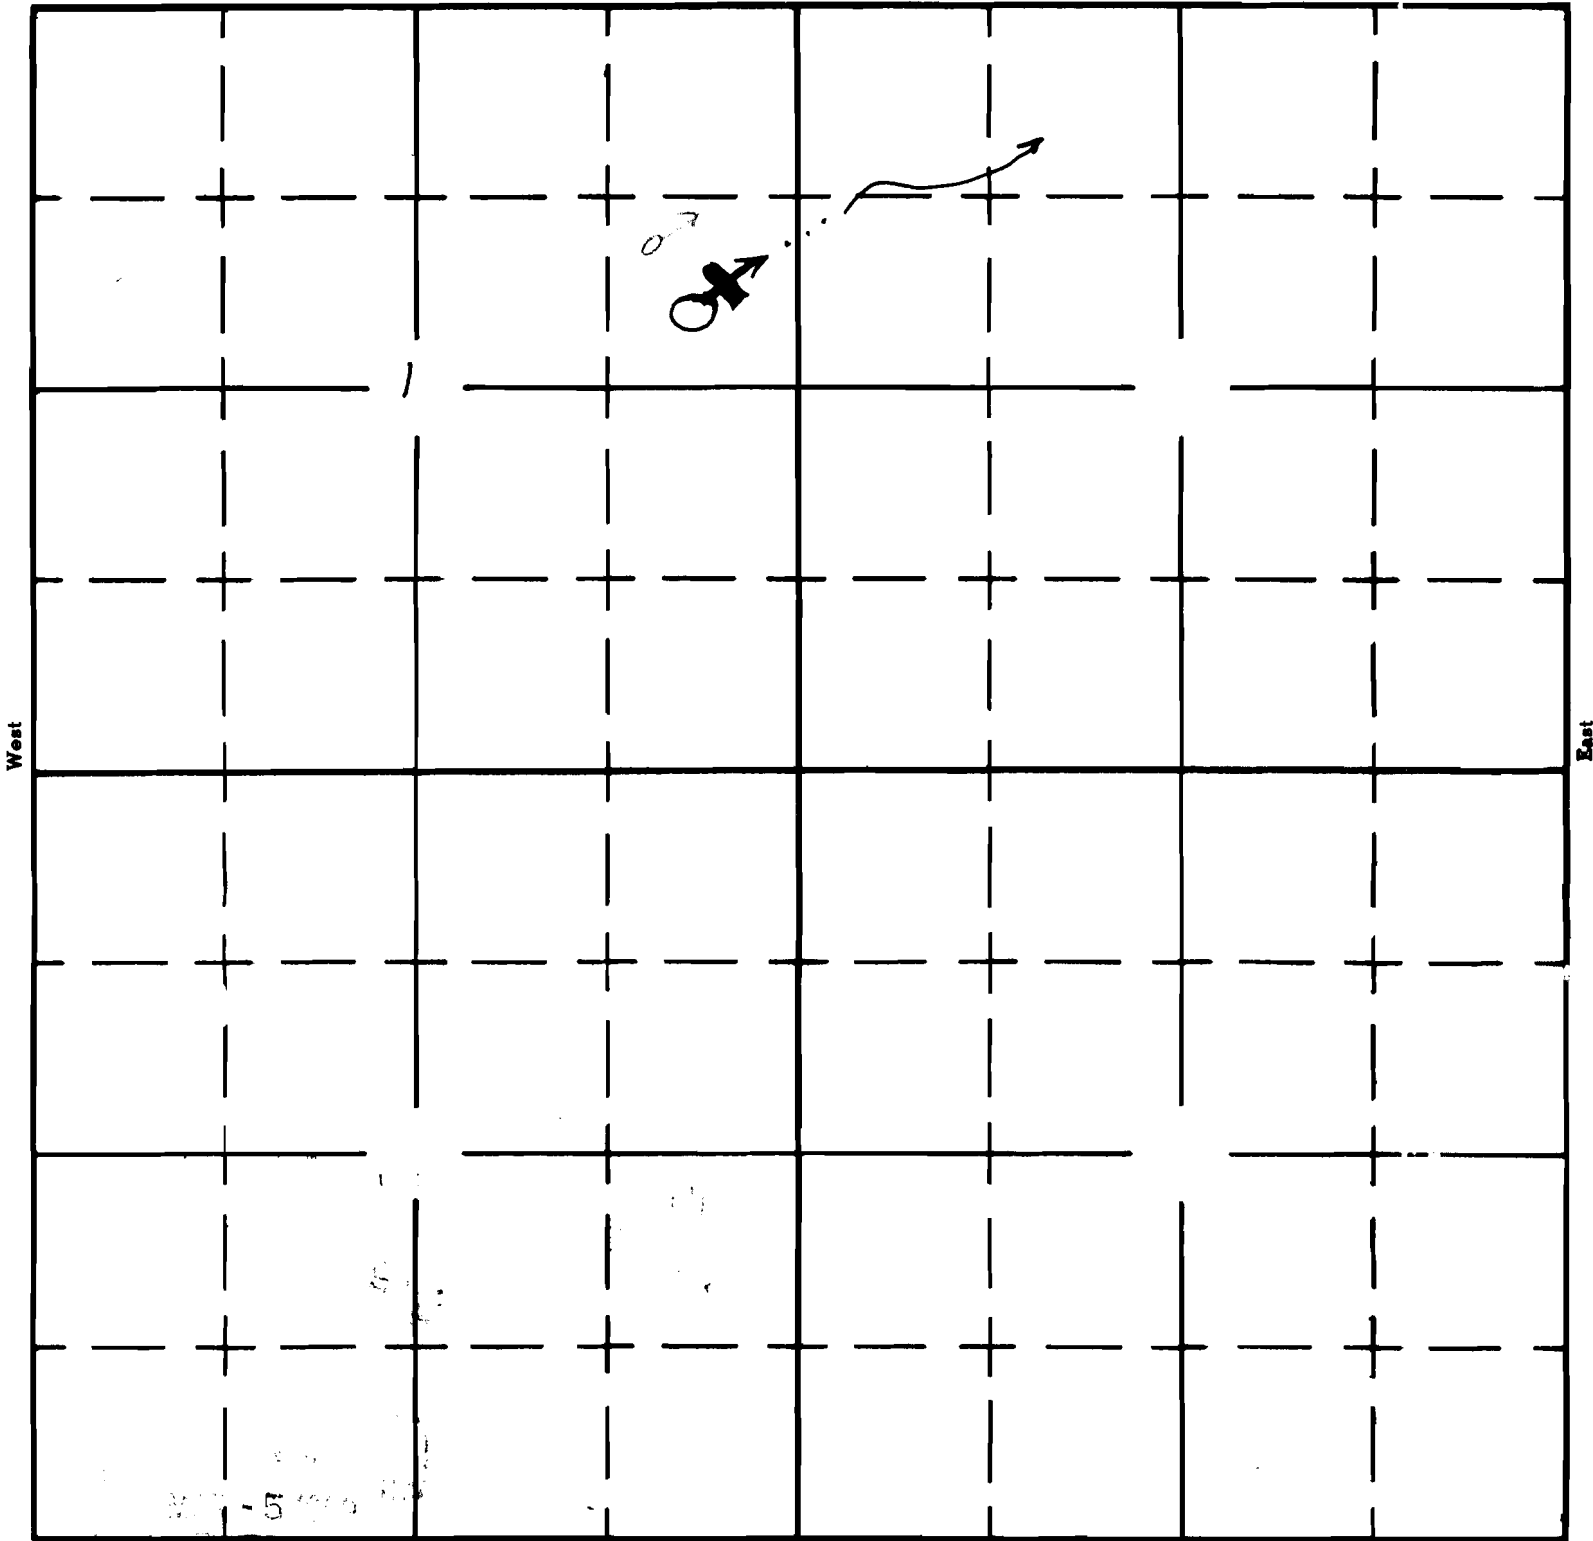

South

APPLICATION No.

PERMIT No.

Form AI-187
March 1961

UNITED STATES
DEPARTMENT OF THE INTERIOR
BUREAU OF LAND MANAGEMENT

SECTION


Oregon State Water Filings

SE 1/4 NE 1/4

TOWNSHIP 41S, RANGE 37E, W. M.

Sec. 1

North

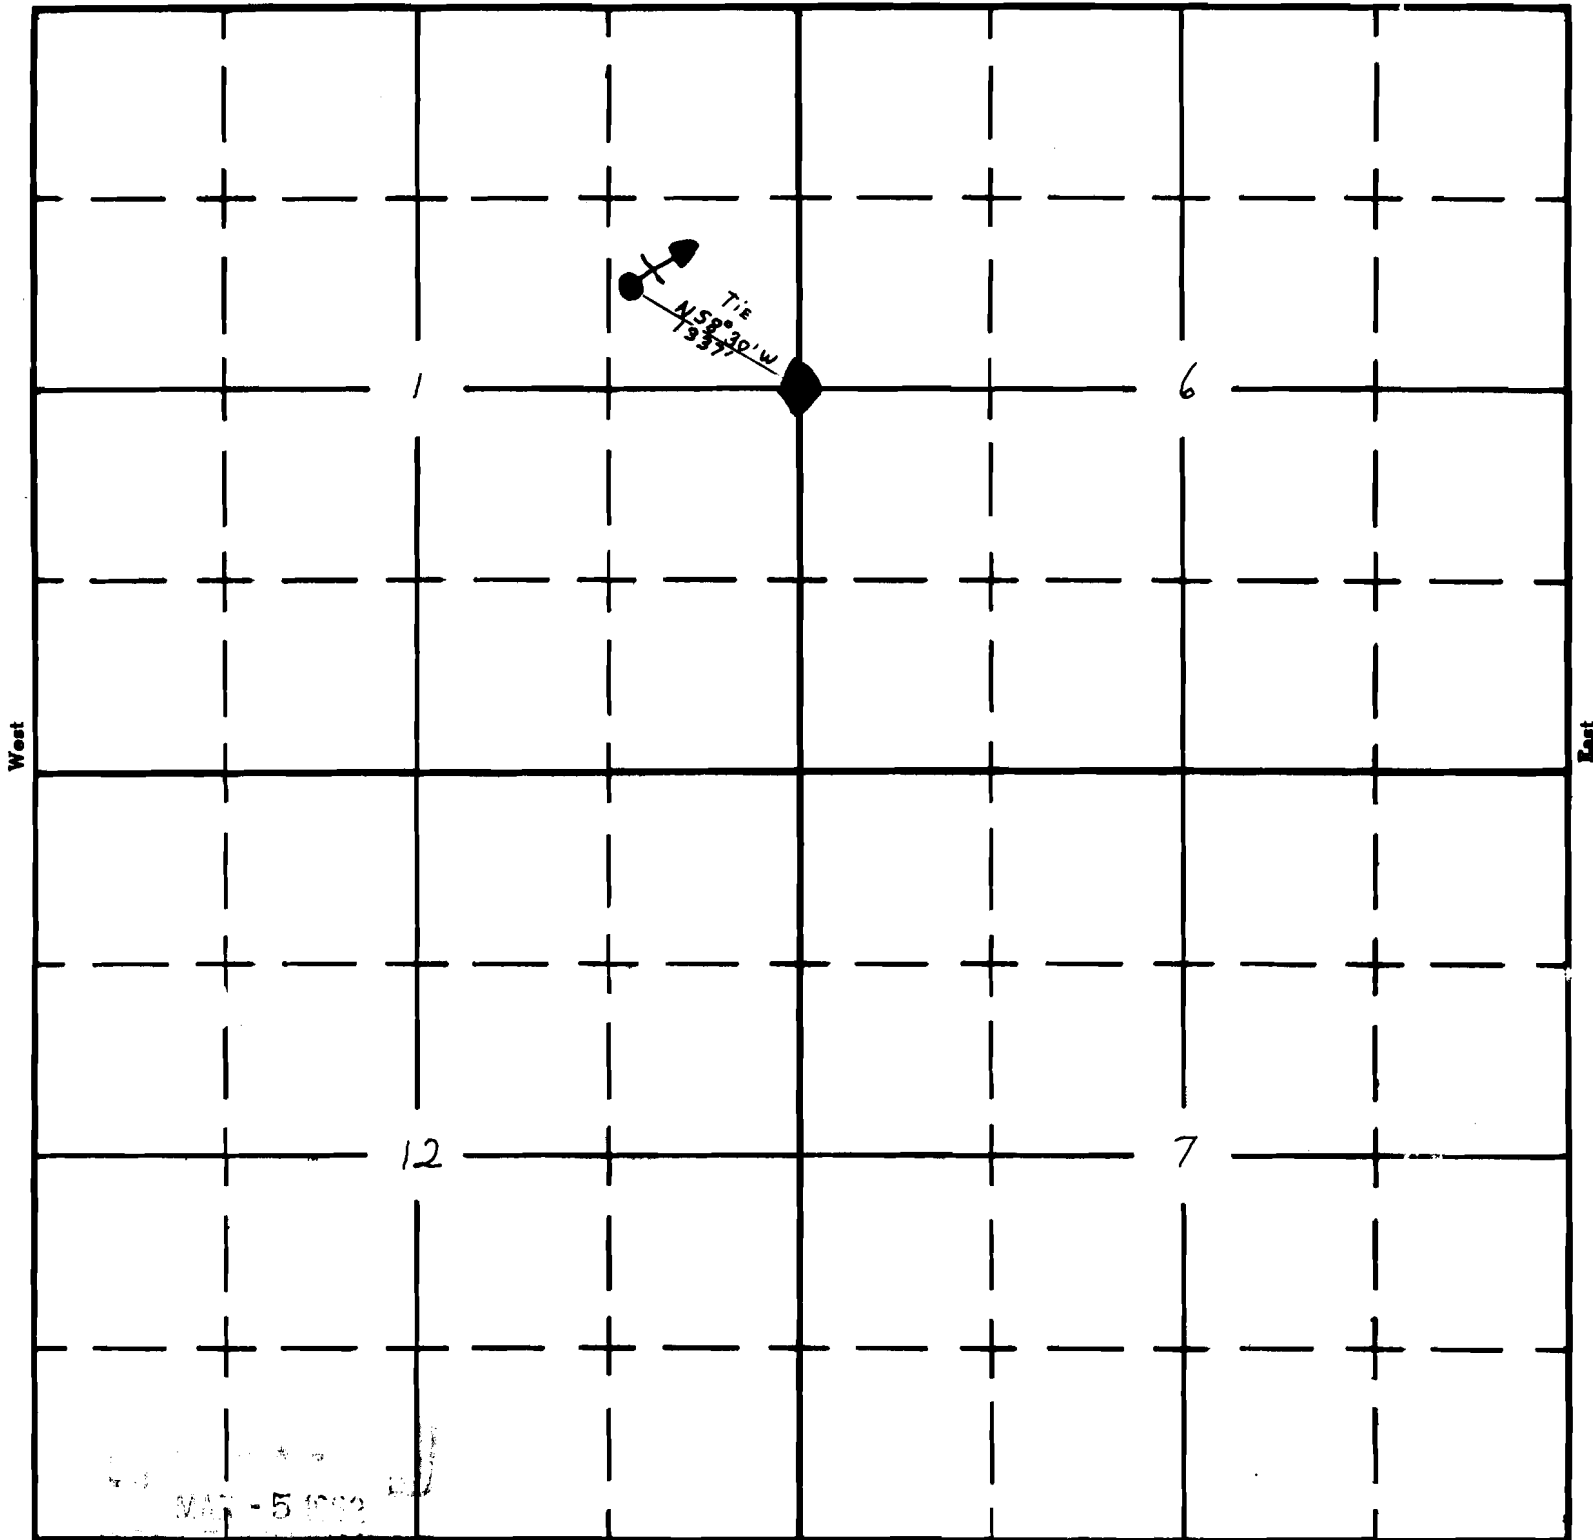

MAF - 5 1982

South

APPLICATION No. 35704

PERMIT No. 29757