
Form A1-187
March 1961

UNITED STATES
DEPARTMENT OF THE INTERIOR
BUREAU OF LAND MANAGEMENT

SECTION SE¼ NW¼ SEC. 27

Oregon State Water Filings

TOWNSHIP 26 S, RANGE 23 E, W. M.

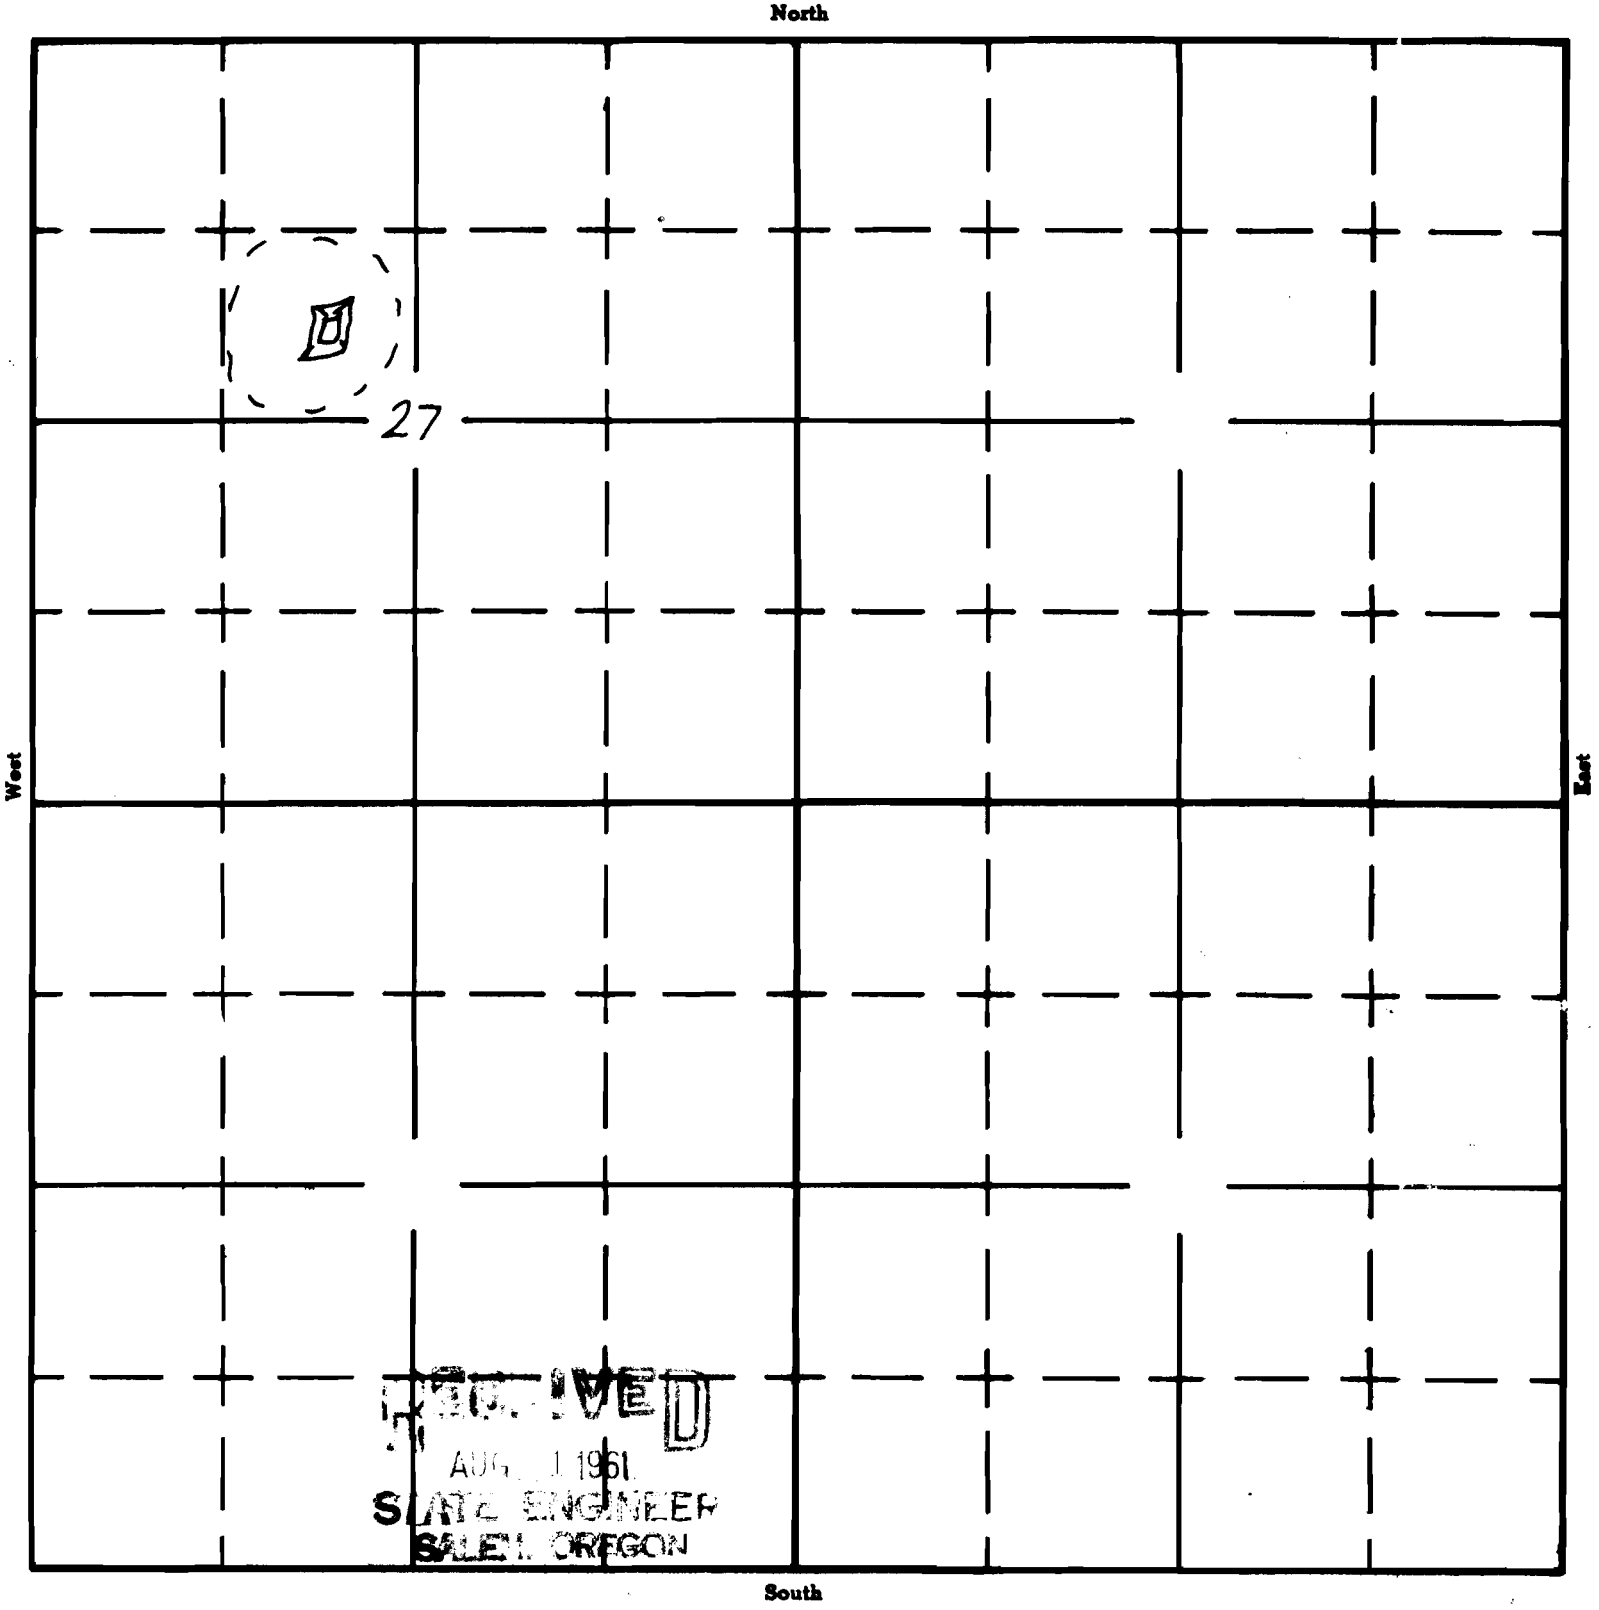

RECEIVED
AUG 1 1961
STATE ENGINEER
SALEM, OREGON

APPLICATION No. R-35883
PERMIT No. R-3439