

Form AI-187
March 1961

UNITED STATES
DEPARTMENT OF THE INTERIOR
BUREAU OF LAND MANAGEMENT

SECTION


31

NW 1/4 SE 4

Oregon State Water Filings

TOWNSHIP 27S, RANGE 25E, W. M.

North Tied in with aerial Photo and OSEP Quad Maps.

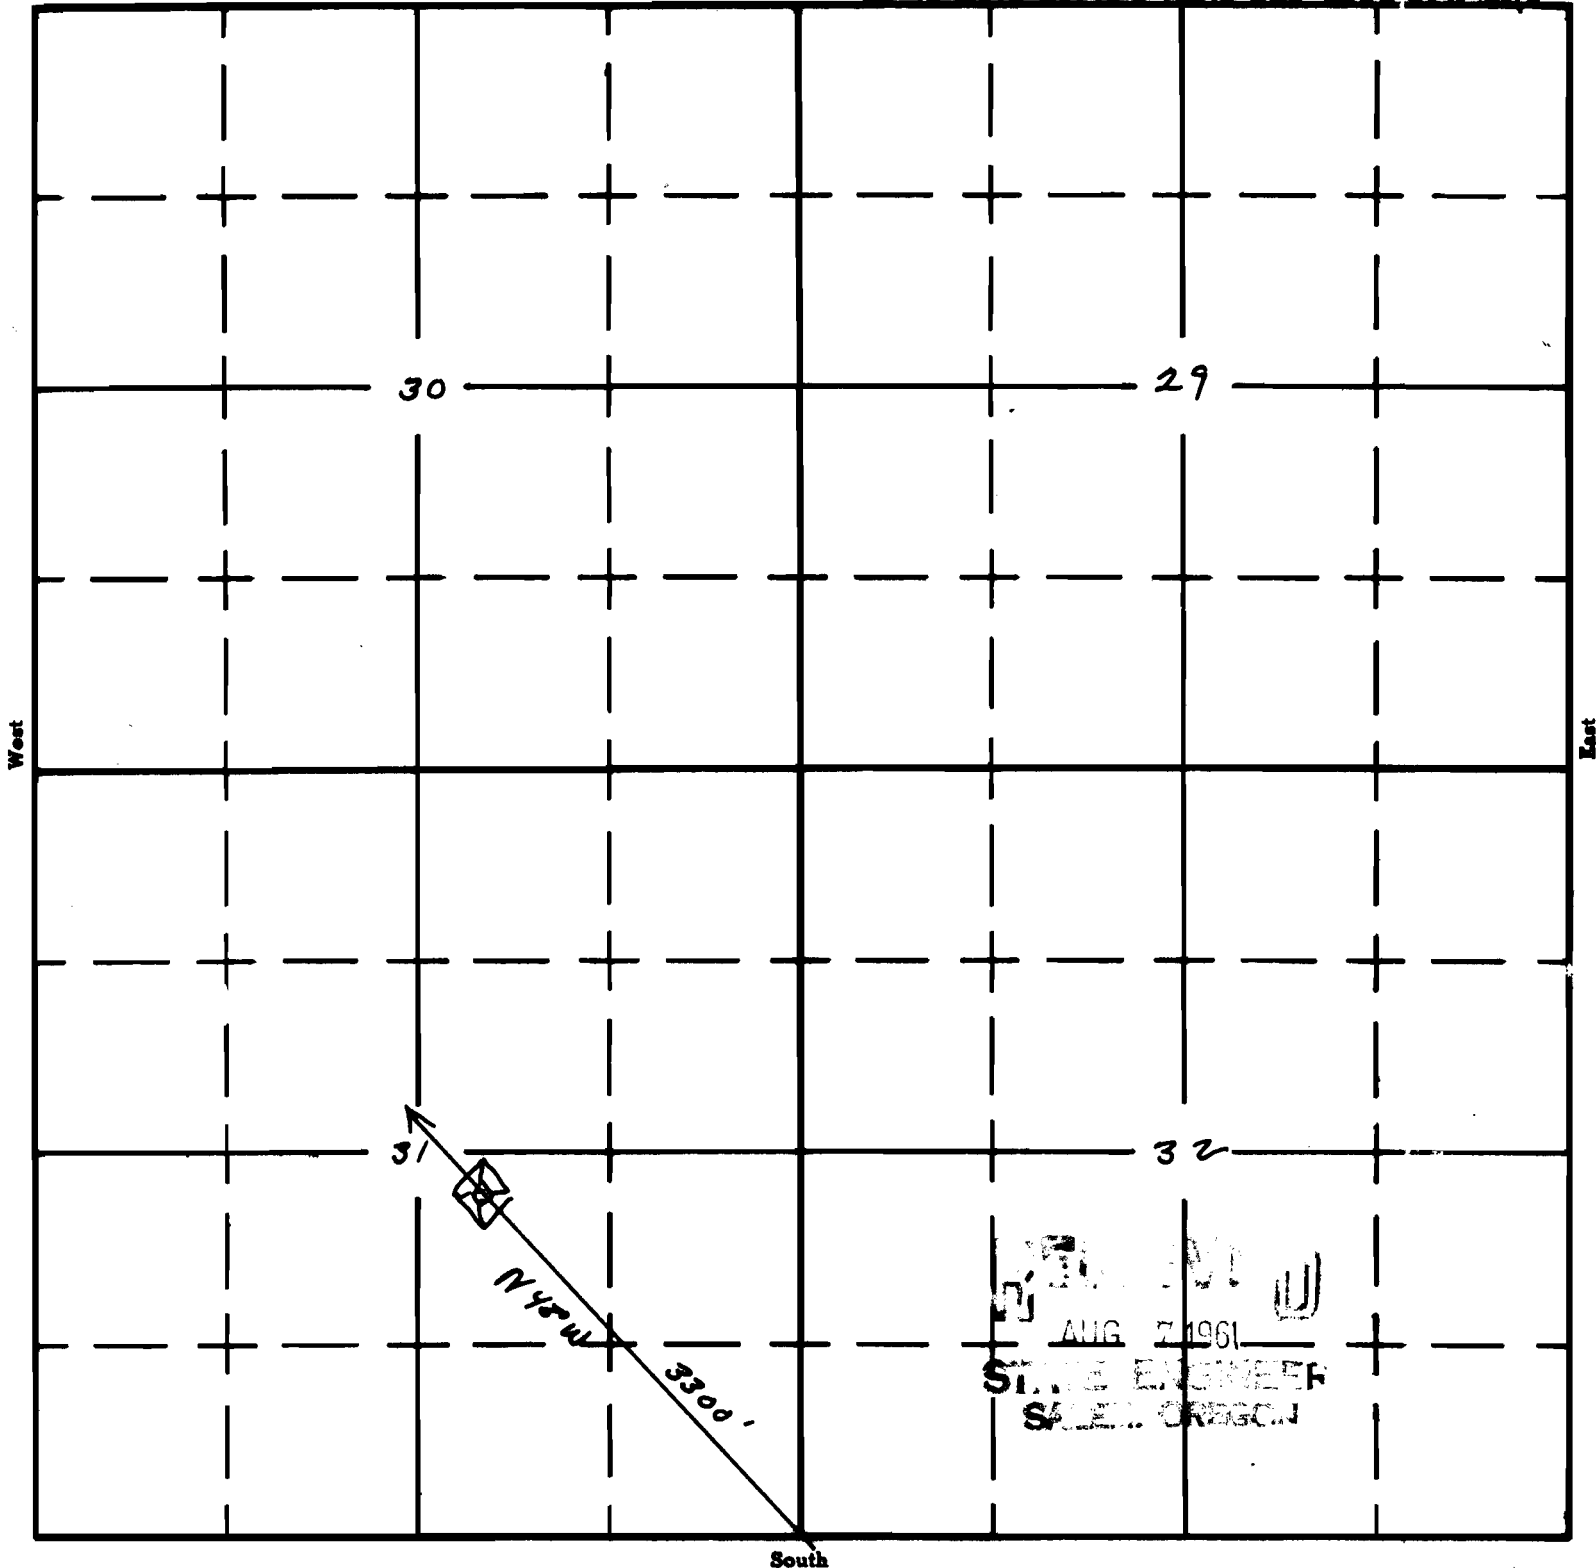

APPLICATION No. R-36338
PERMIT No. R-2684