

UNITED STATES
DEPARTMENT OF THE INTERIOR
BUREAU OF LAND MANAGEMENT

SECTION


18

Oregon State Water Filings

SE 1/4 NW 1/4

TOWNSHIP 41S, RANGE 26E, W. M.

North

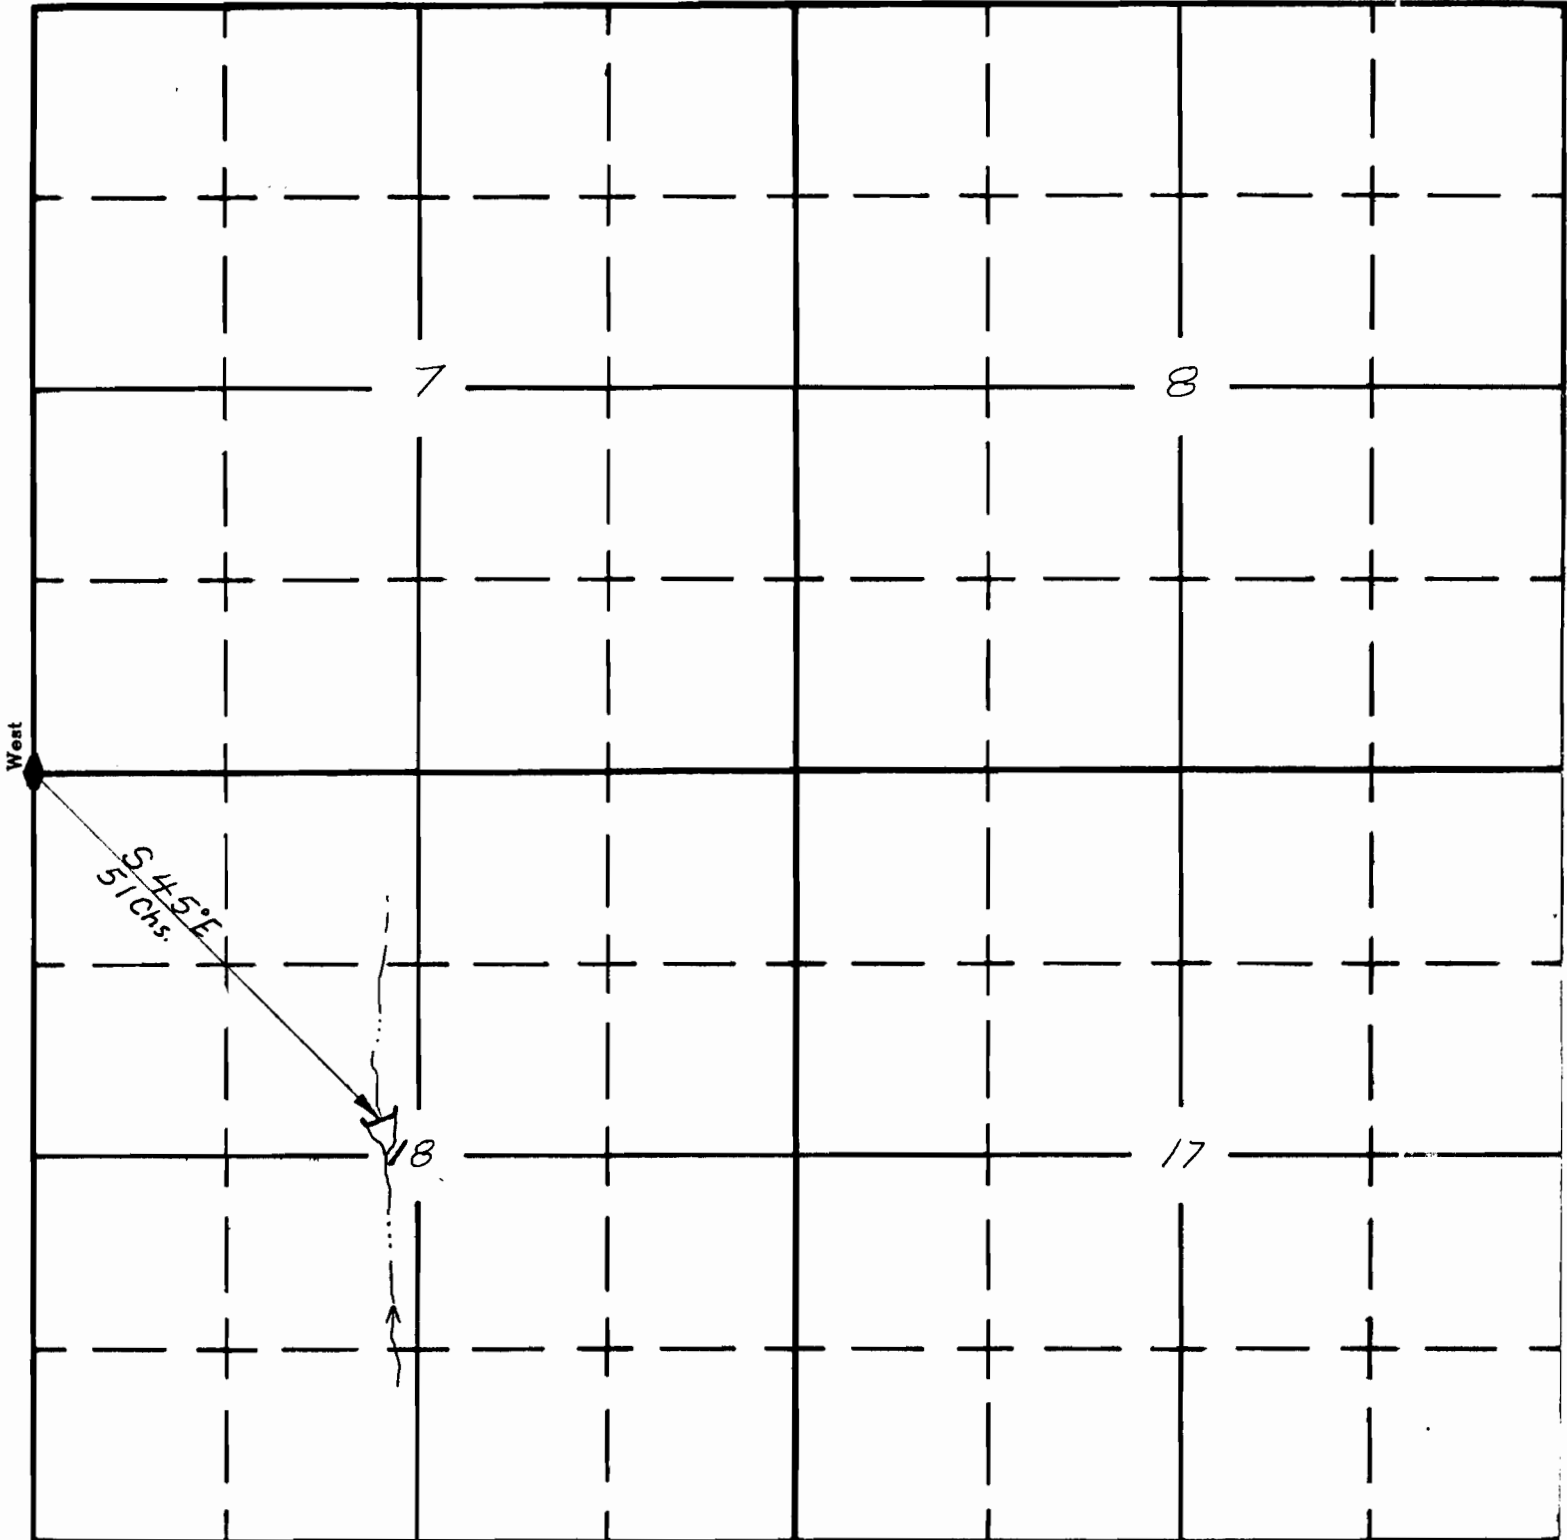

West

South

Mike S. Res.

01-R-249

APPLICATION No. R-3859
PERMIT No. R-434