


Range R11E  
2N-11E

6363

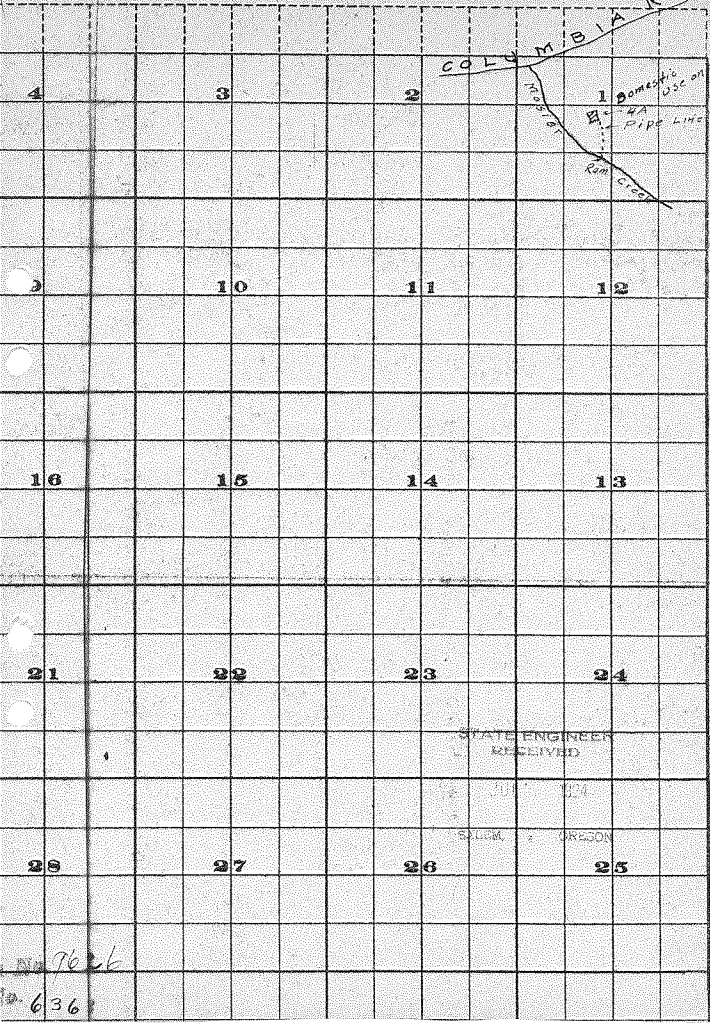

No 7626  
6363

STATE ENGINEER  
RECEIVED  
JUL 1904  
SALM, OREGON