



SCALE
4" = 1 mile

NORTH

Cow Creek Complex Site #1
Rainbow Spring

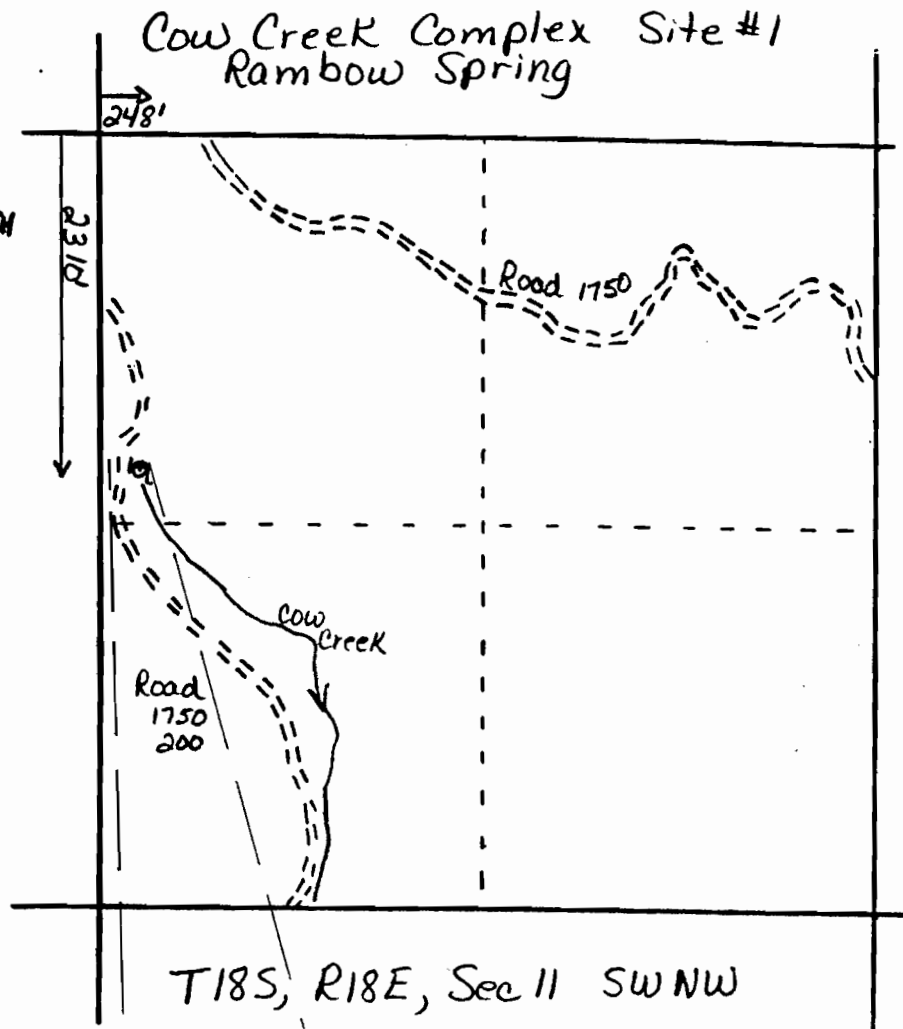

Application No. 66345
Permit No. 49530

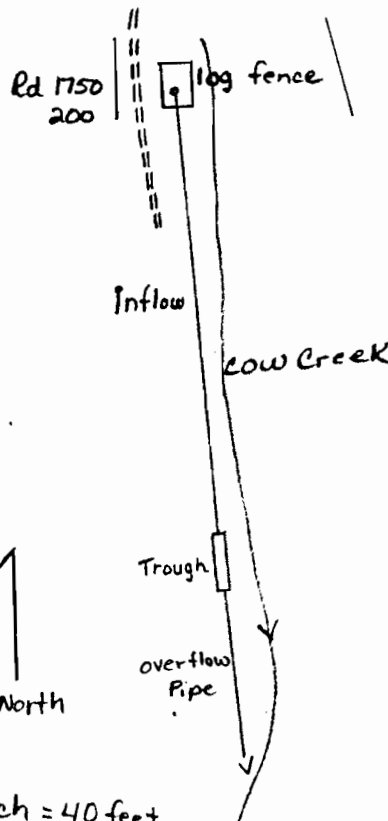

RECEIVED
SEP 19 1983
WATER RESOURCES DEPT.
SALEM, OREGON

North

Scale: 1 inch = 40 feet