


Klootchman Complex Site #1
Wee Spring

SCALE
4" = 1 mile


NORTH

RECEIVED
SEP 19 1983
WATER RESOURCES DEPT.
SALEM, OREGON

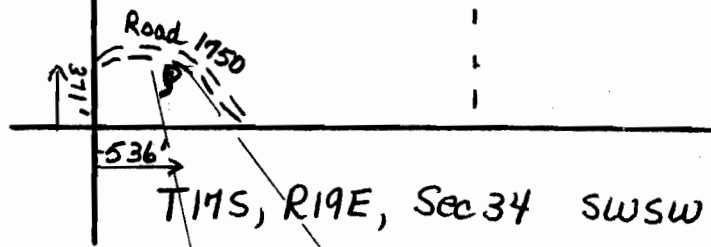

Application No. 66350
Permit No. 49535

North

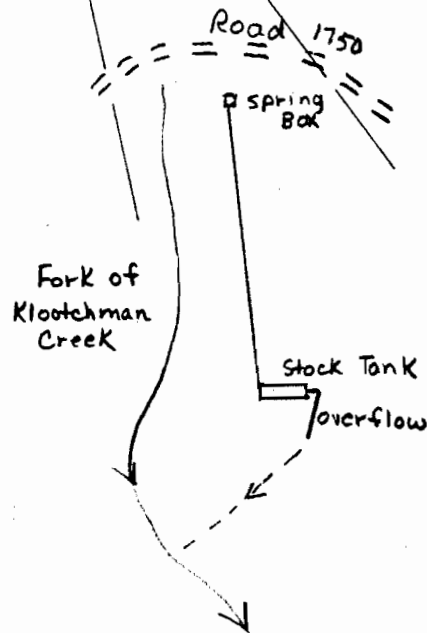

Scale : 1 inch = 40 feet