


T18S, R18E, Sec 12 NE 1/4 SW 1/4

SCALE
4" = 1 mile

NORTH

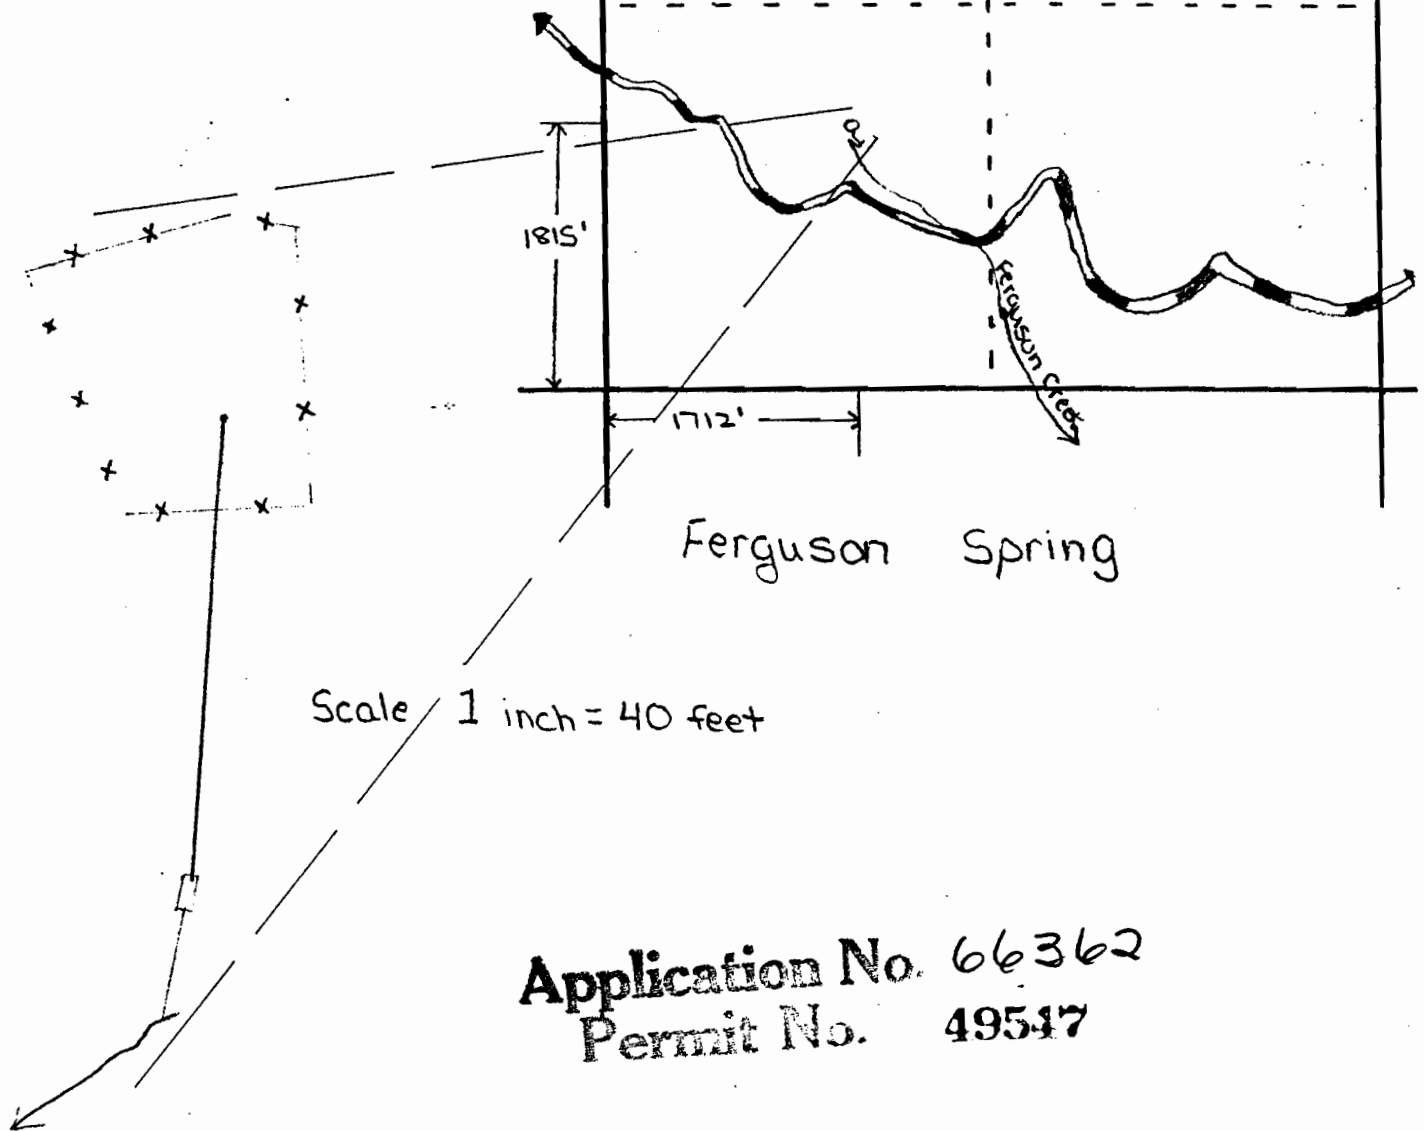


Application No. 66362
Permit No. 49547

SEP 19 1983
WATER RESOURCES DEPT.
SALEM, OREGON


Belnap Spring

SCALE
4" = 1 mile

NORTH

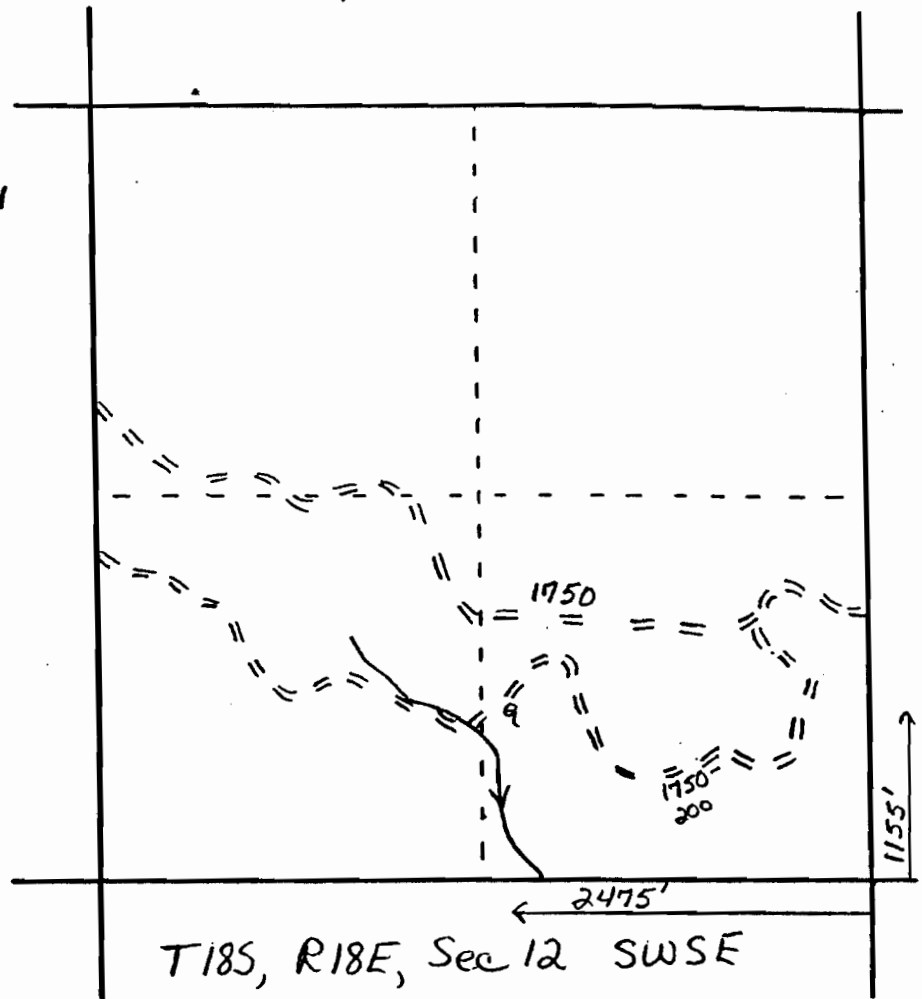

Application No. 66362
Permit No. 49547

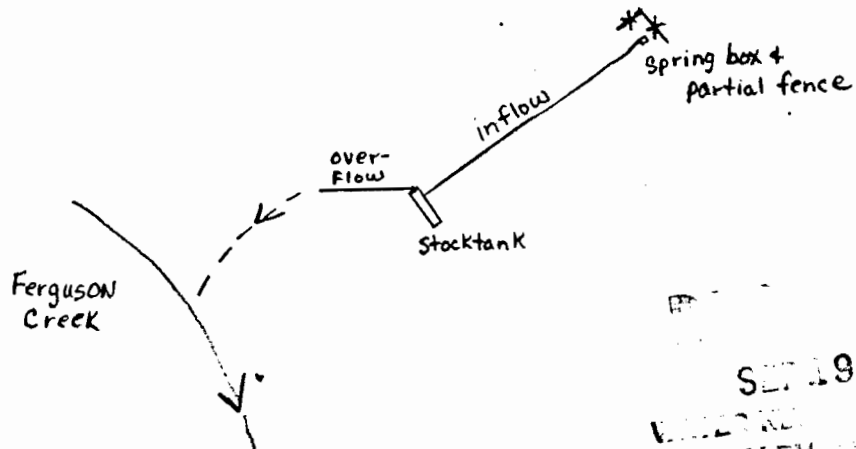

RECEIVED
SEP 19 1983
WATER RESOURCES DEPT.
SALEM, OREGON