


32
SE NE

TOWNSHIP 39 S., RANGE 32 E., W. M.

North

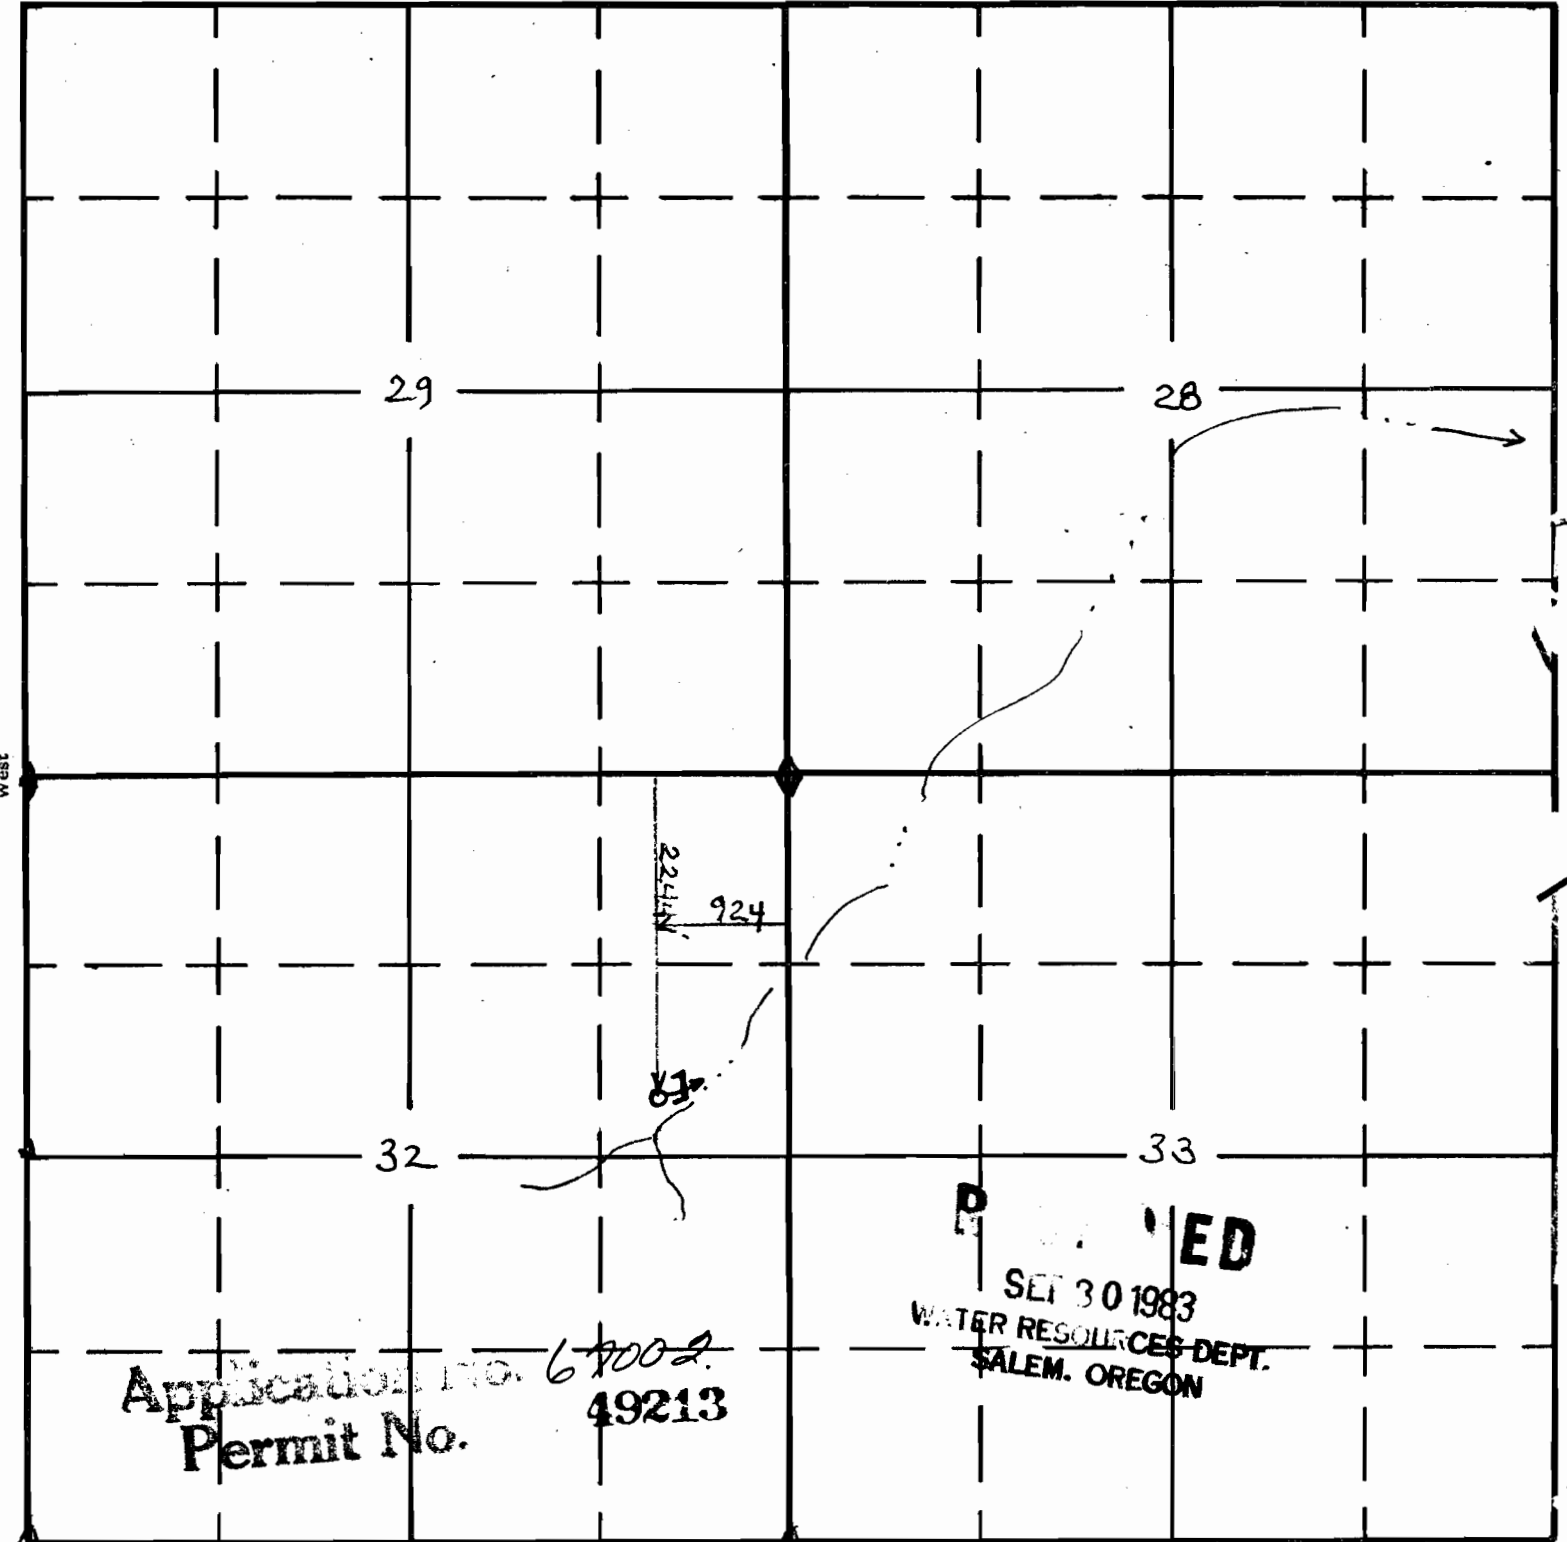

South