


RECEIVED

OCT 13 1983

WATER RESOURCES DEPT.
SALEM, OREGON

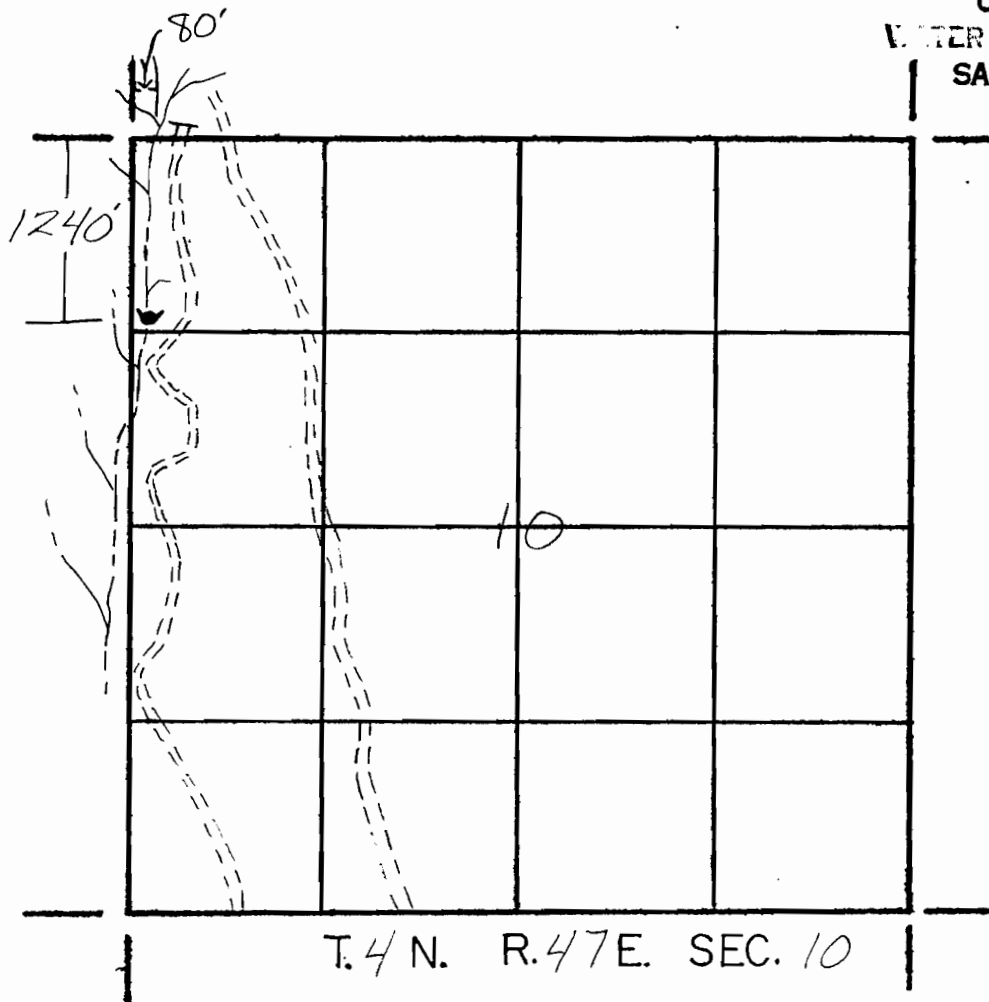

↑
N

4 Inches = 1 Mile

Application No. R67569
Permit No. R10085

Prepared By _____