

Form OR-010-7300-2
4/83

UNITED STATES
DEPARTMENT OF THE INTERIOR
BUREAU OF LAND MANAGEMENT

Section

24

Township

41S

Appl. No.

67678

NWNE

Range

24E


Permit No.

48890

Will. Mer.

8" = 1 mile

PEDERSON SPRING 4681

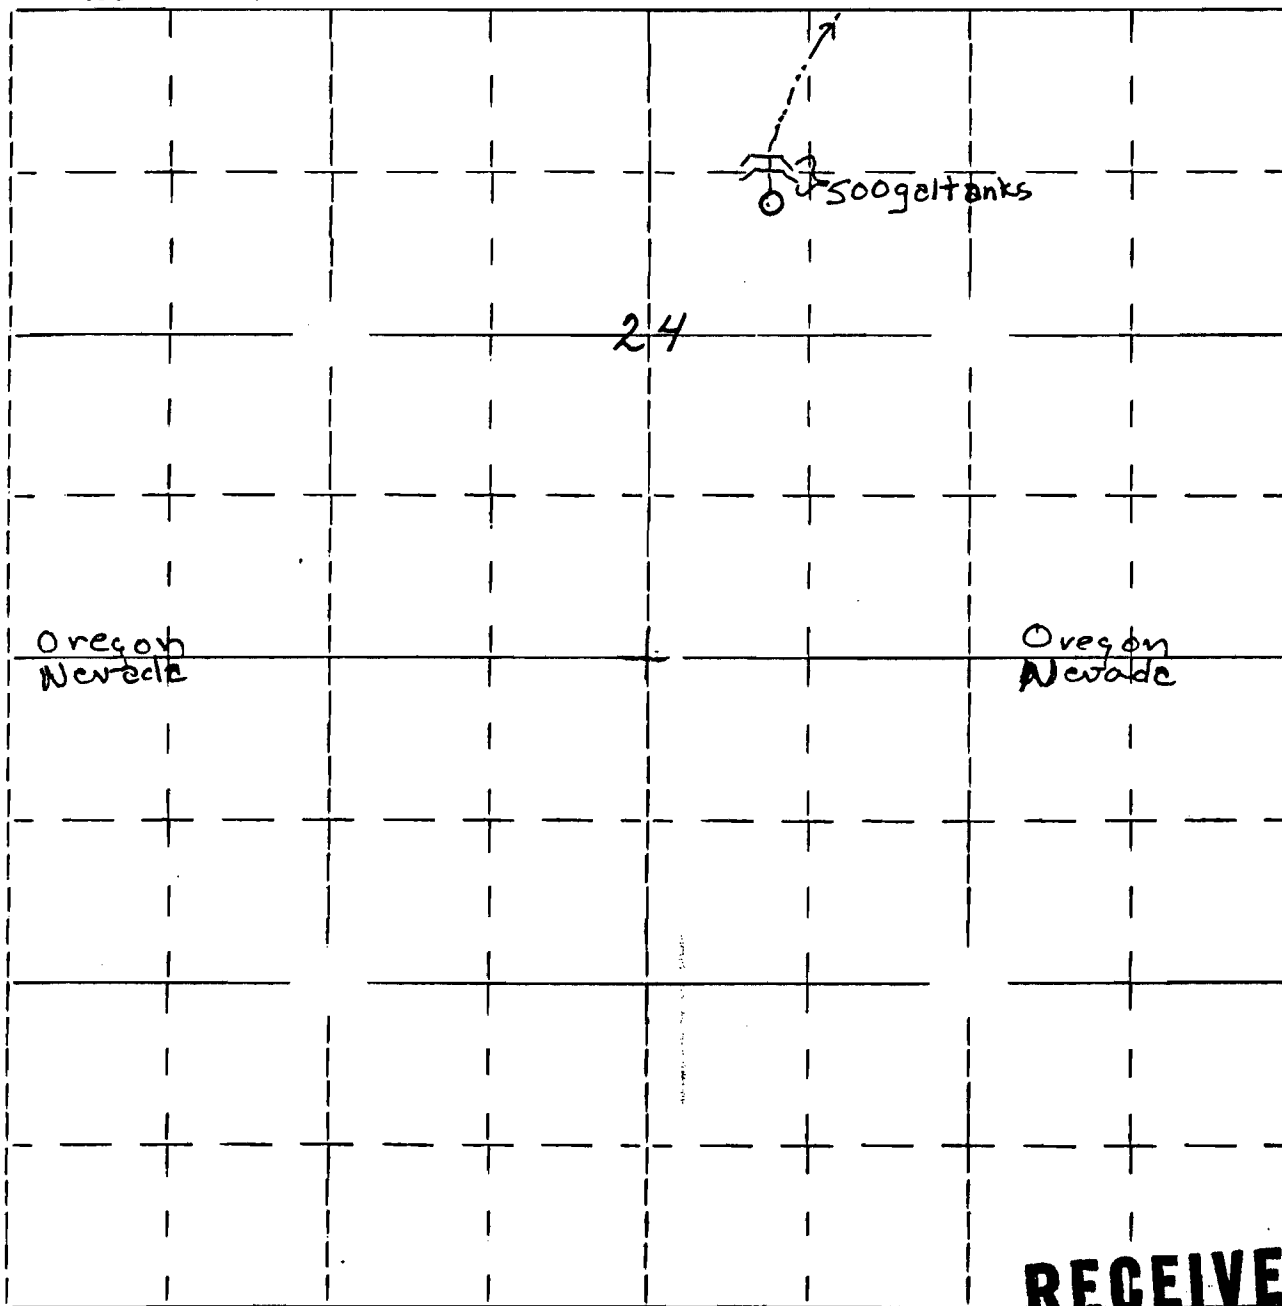

OCT 13 1983
WATER RESOURCES DEPT.
SALEM, OREGON