

Form OR-010-7300-2
4/83

UNITED STATES
DEPARTMENT OF THE INTERIOR
BUREAU OF LAND MANAGEMENT

Section

4

Township

39S

Appl. No.

67679

N E N W

Range

24E

Permit No.


48891

8" = 1 MILE

Will. Mer.

Job # 0829

CRUMP SPRING

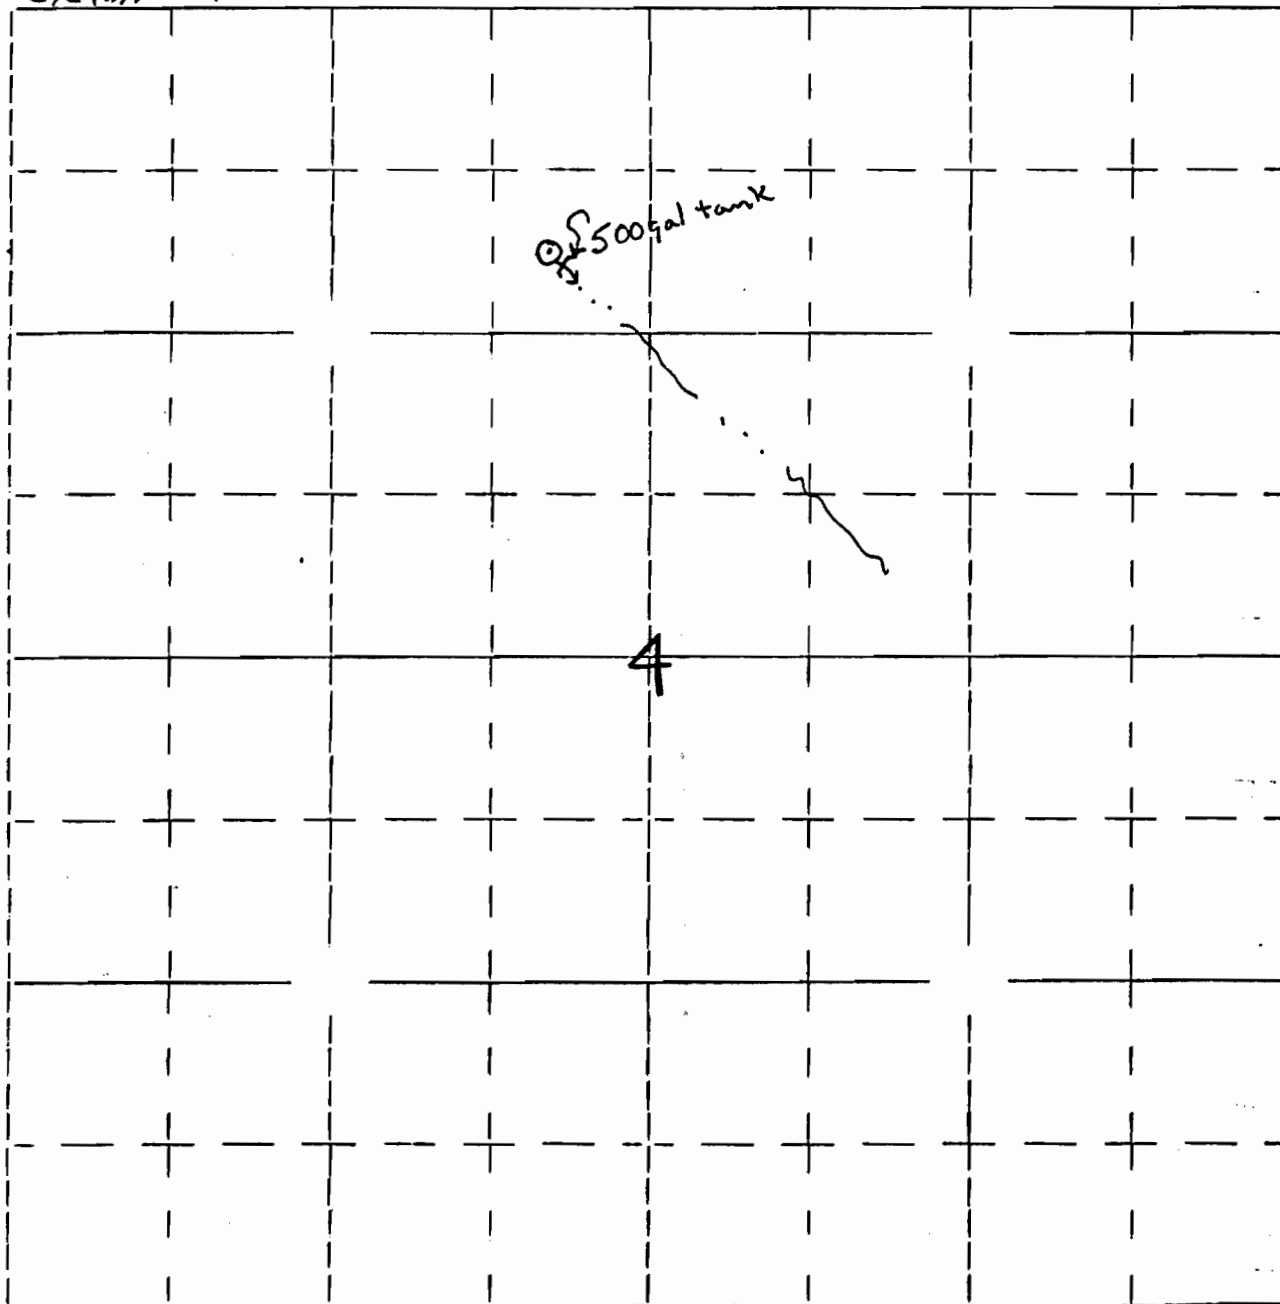

1000 ft South and 2240 ft East
of the NW corner of sec 4

RECEIVED

OCT 18 1983

WATER RESOURCES DEPT.
SALEM, OREGON