

Form OR-010-7300-2
4/83

UNITED STATES
DEPARTMENT OF THE INTERIOR
BUREAU OF LAND MANAGEMENT

Section

11

Township 36S

Appl. No. 67680

NESE


Range 21E

Permit No. 48892

4" = 1 MILE

Will. Mer.

Shellhammer Spring #4524

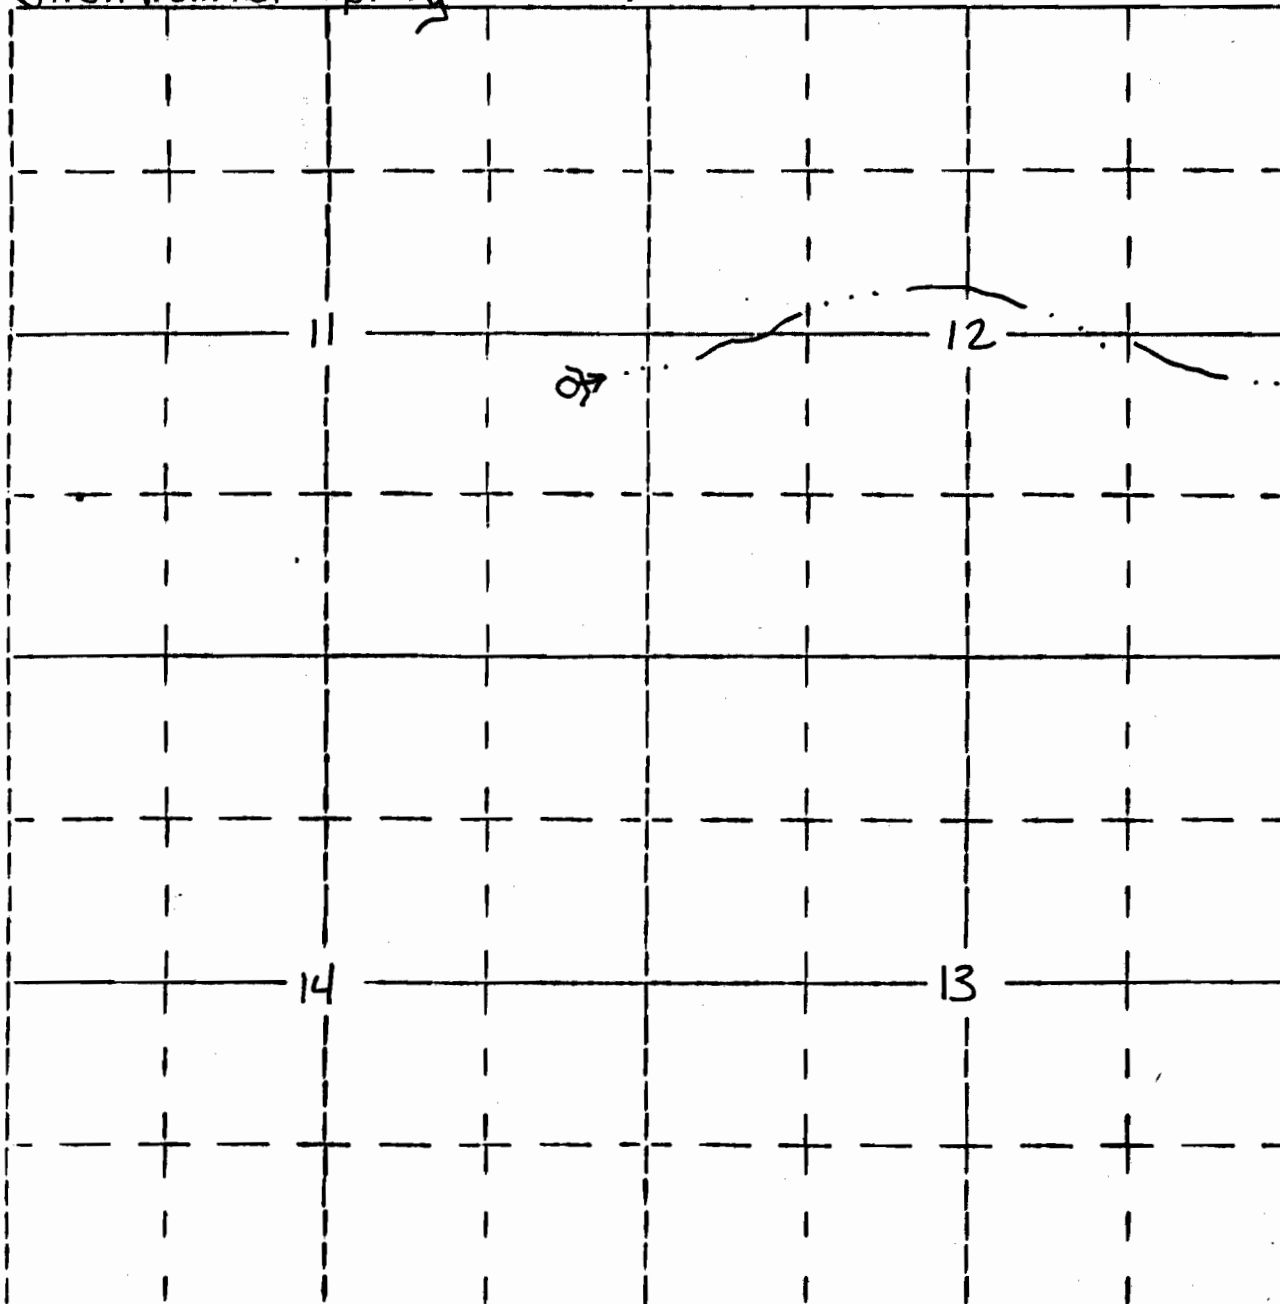

2,100' N, 600' W of the SE corner of Section 11

RECEIVED

OCT 13 1983
WATER RESOURCES DEPT.
SALEM, OREGON