

Form OR-010-7300-2
4/83

UNITED STATES
DEPARTMENT OF THE INTERIOR
BUREAU OF LAND MANAGEMENT

Section

11

Township 41S

Appl. No. 67681

SW NW

Range 24E


Permit No. 48893

Will. Mer.

Job # 0917

TERRY SPRING

8" = 1 mile

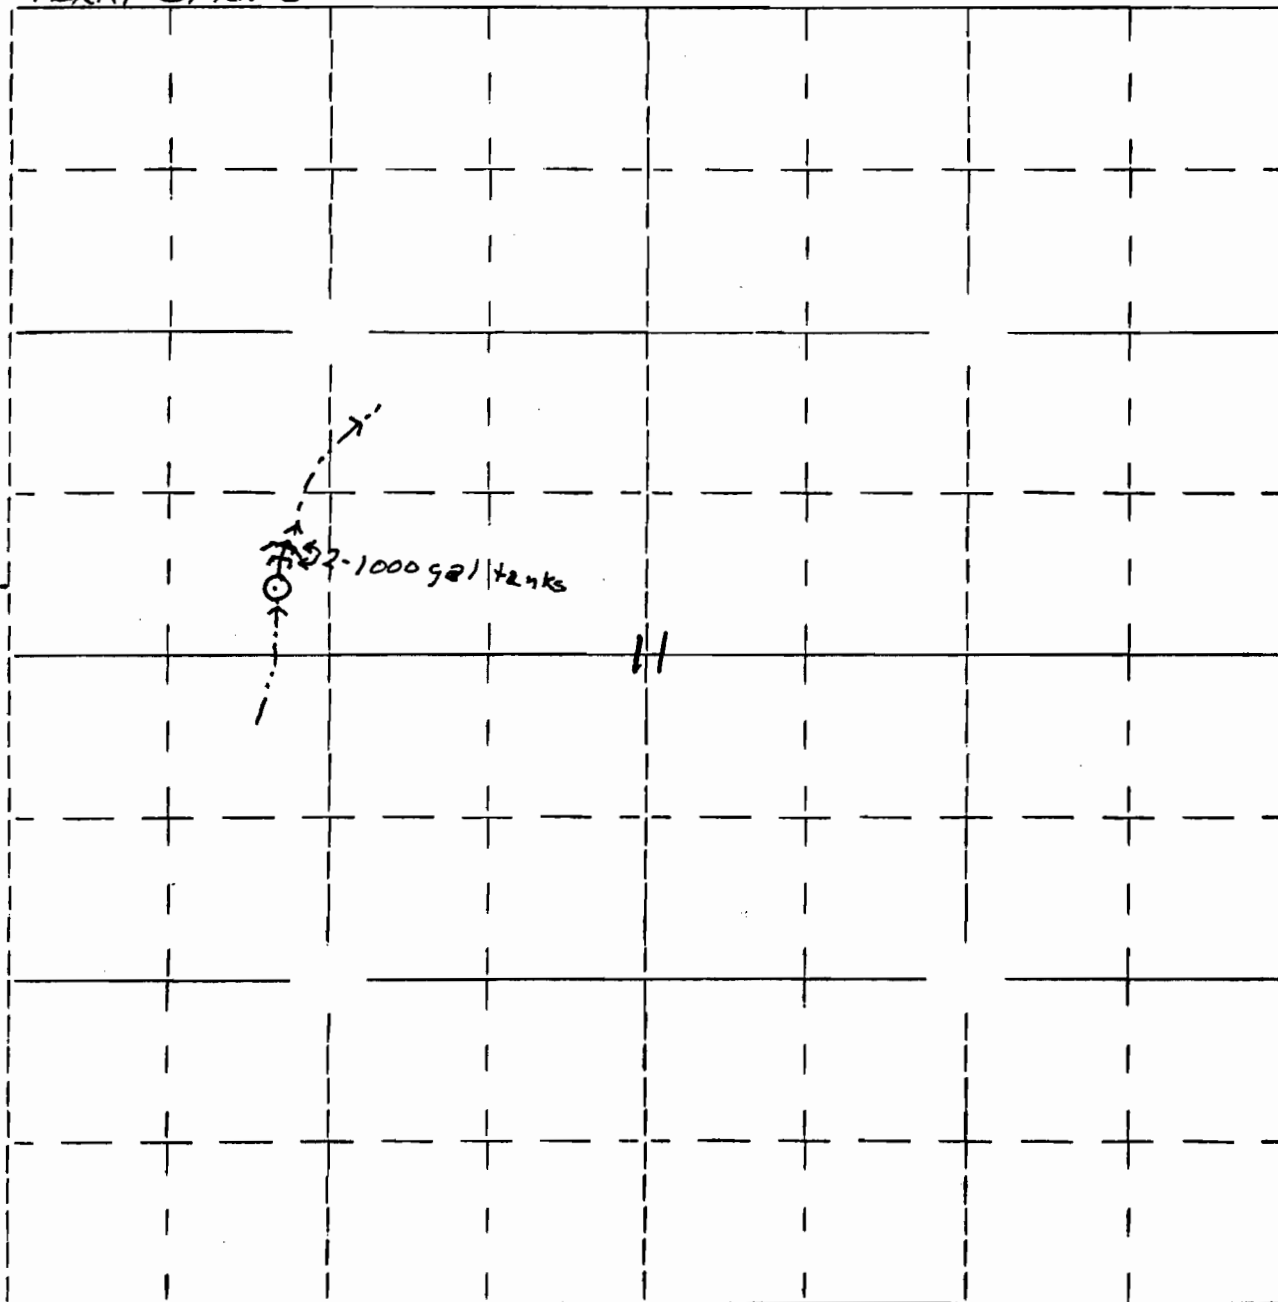

2400' South and 1120' East
of the NW corner, Sec 11

RECEIVED

OCT 13 1983

WATER RESOURCES DEPT.
SALEM, OREGON