

Form A1-187
March 1961

UNITED STATES
DEPARTMENT OF THE INTERIOR
BUREAU OF LAND MANAGEMENT

RECEIVED

OCT 13 1963

WATER RESOURCES DEPT.
SALEM, OREGON


SECTION
30
NWNW

Oregon State Water Filings

TOWNSHIP 36S, RANGE 29E, W. M.

4"=1m.
Willow Springs #3503

North

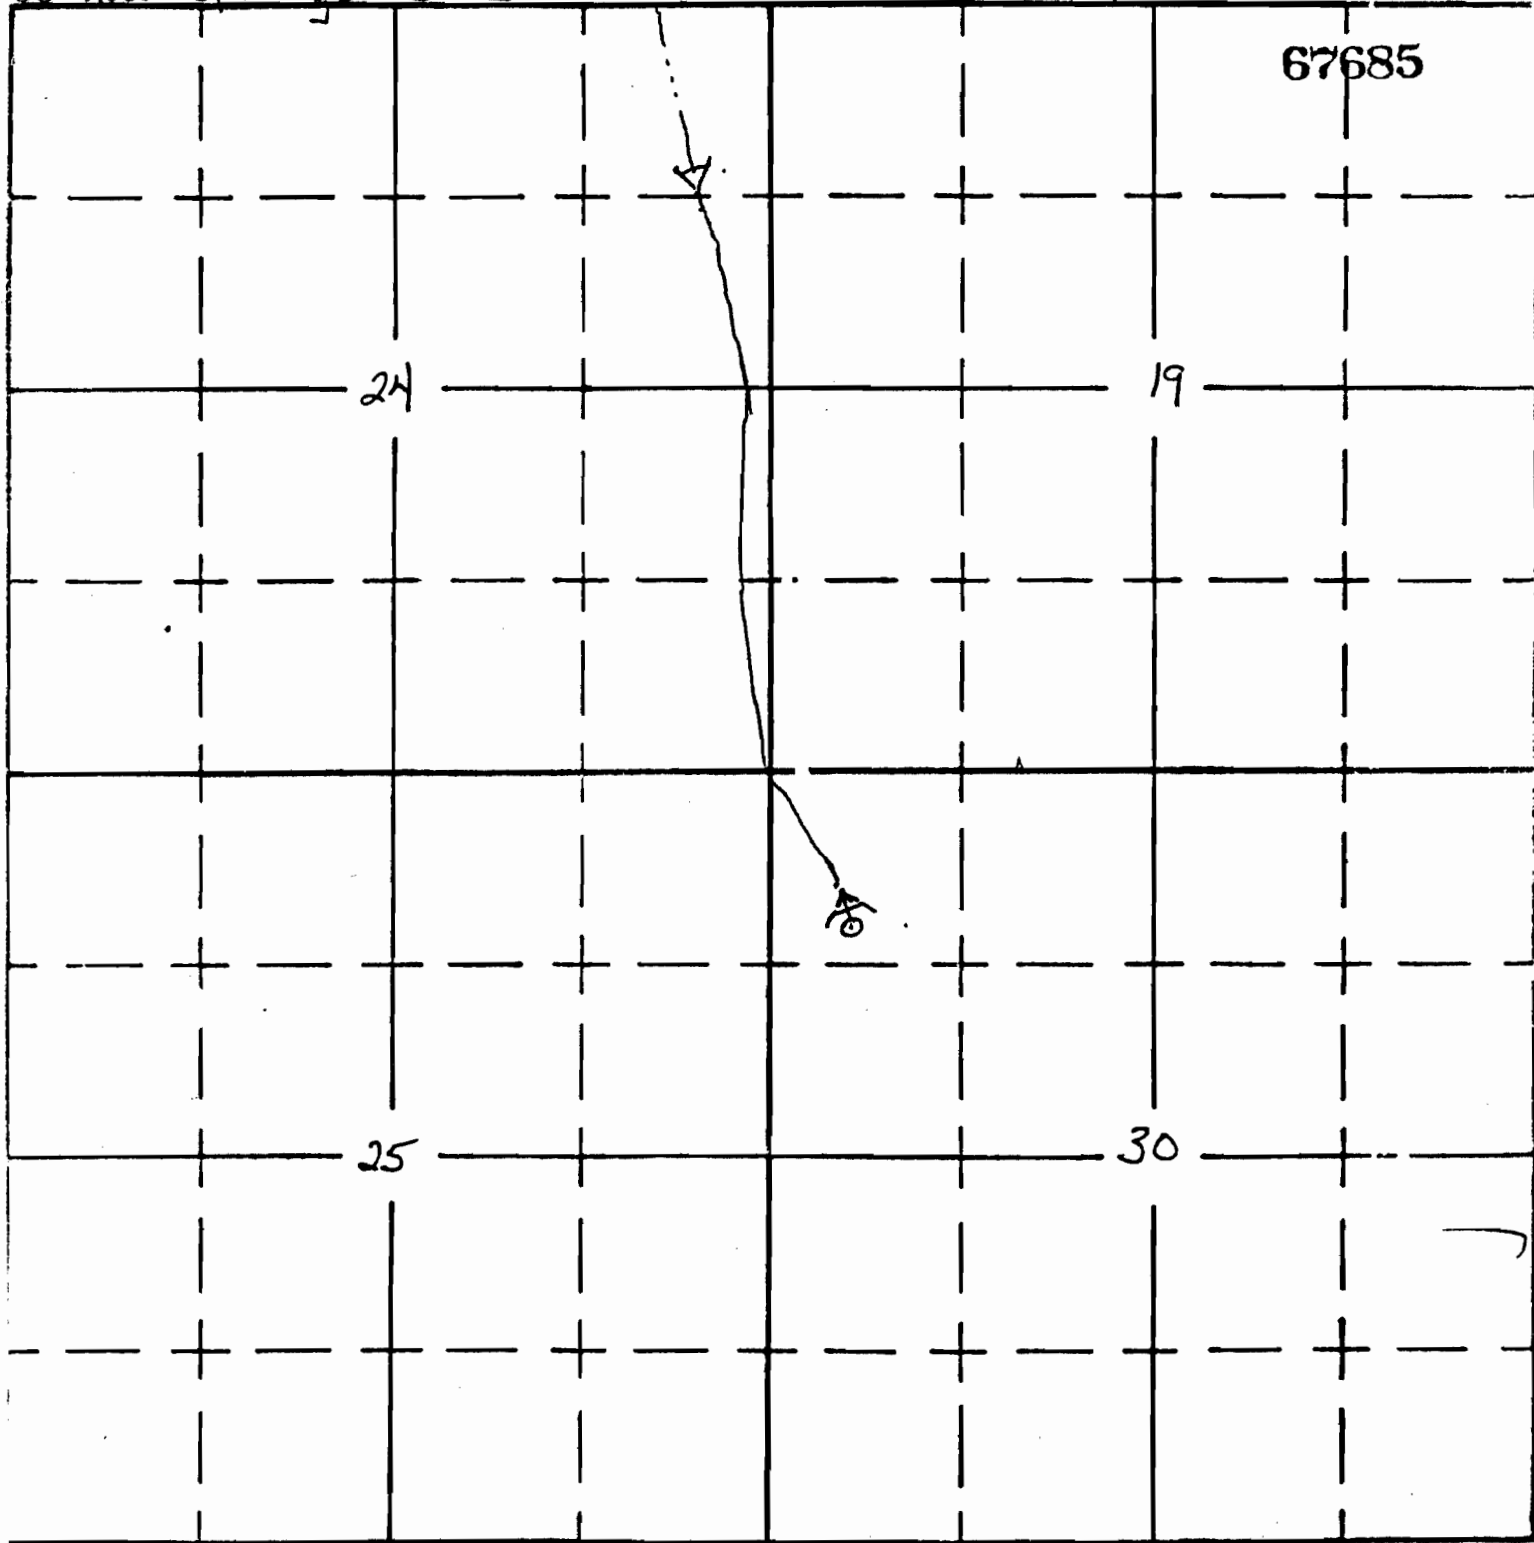

R28E

South

R29E

Spring: 1080's, 550'E of the NW corner of section 30
1120's 520'E of the NE corner of section 24

67685
APPLICATION No. 48897