

UNITED STATES
DEPARTMENT OF THE INTERIOR
BUREAU OF LAND MANAGEMENT

SECTION


15

Oregon State Water Filings

TOWNSHIP 205, RANGE 40E, W. M.

Millers Creek Res.

North

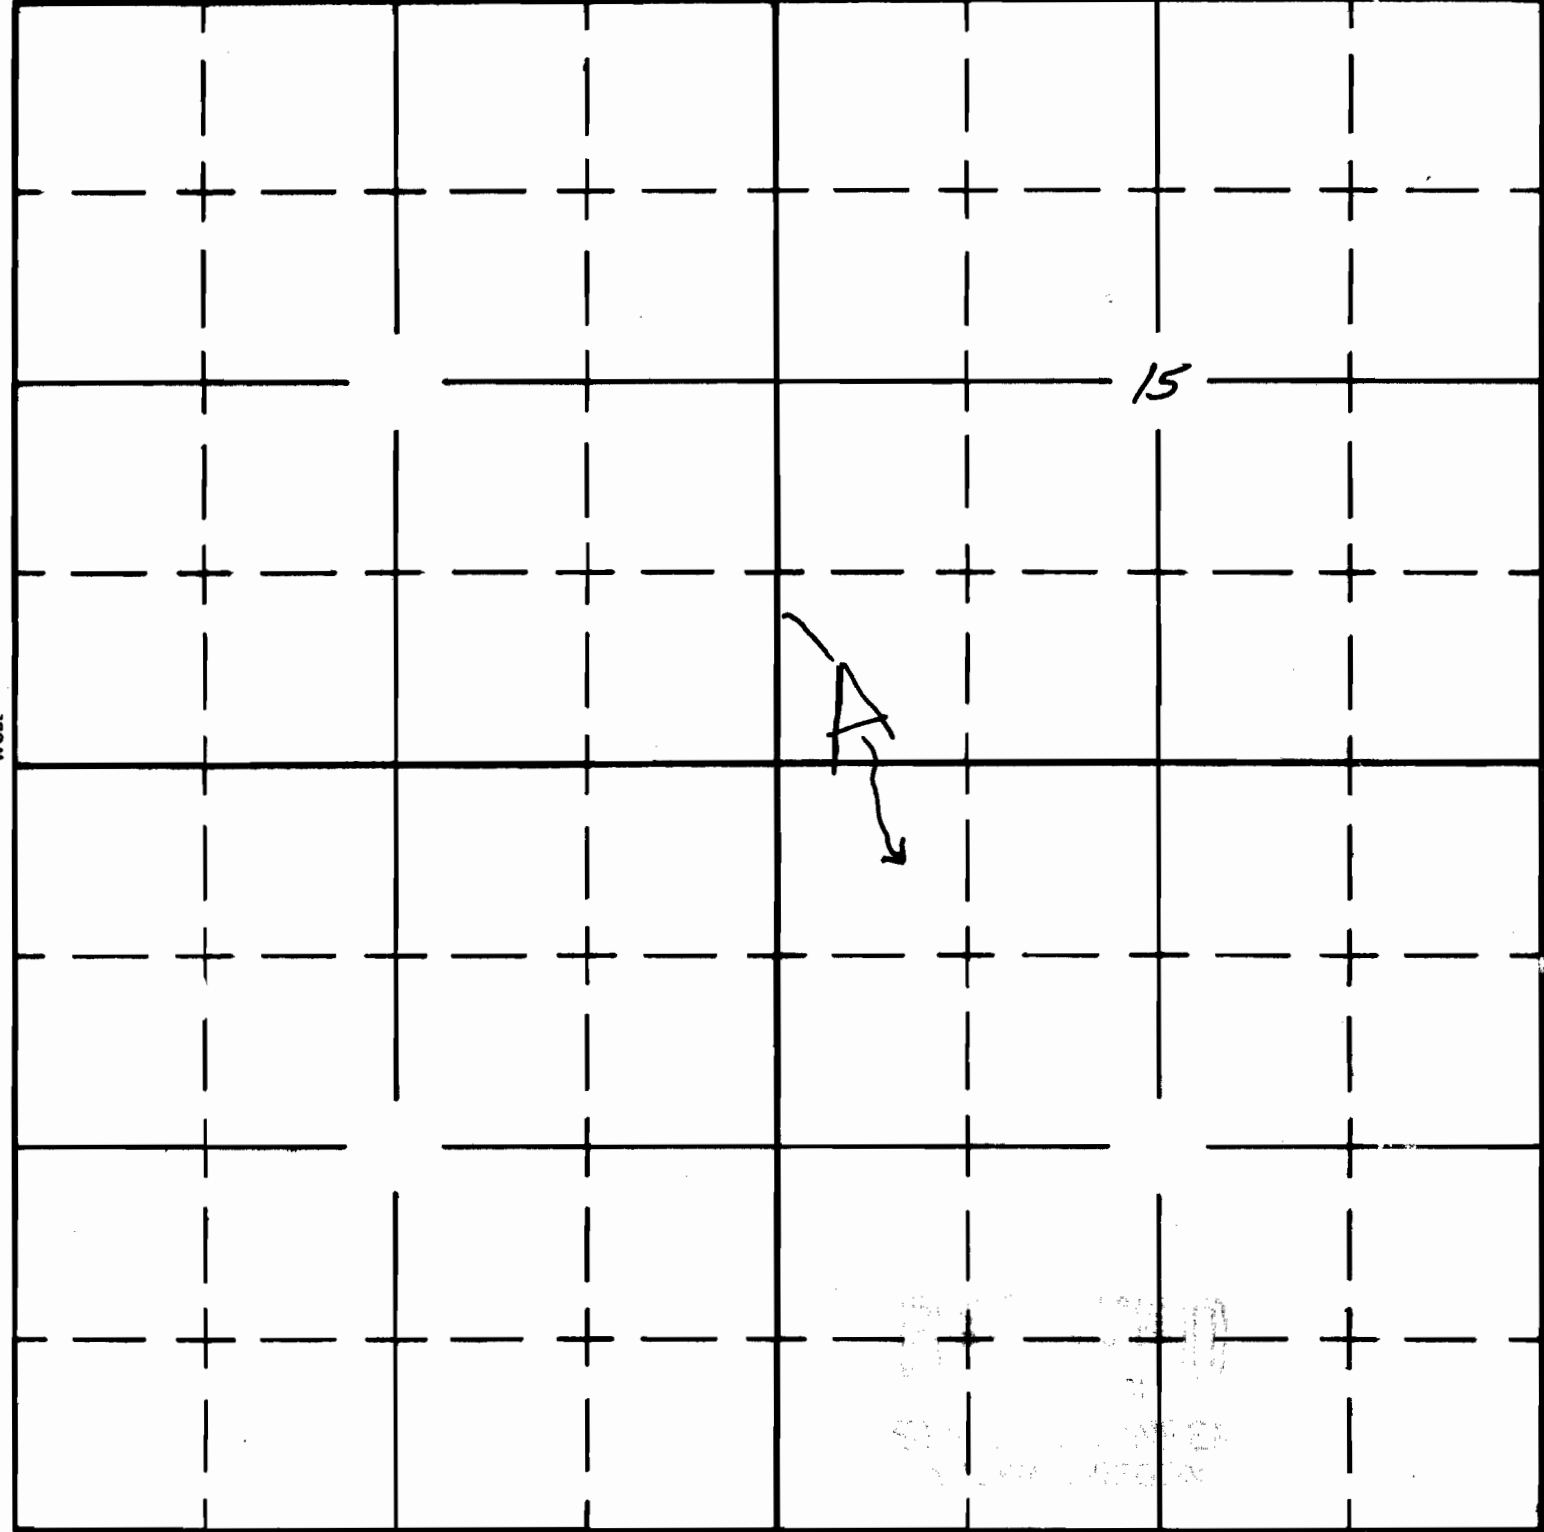

South