


T 5 S R 37 E W.M.

Section 26

RECEIVED

SEPT 2 1983

WATER RESOURCES DEPT.
SALEM, OREGON

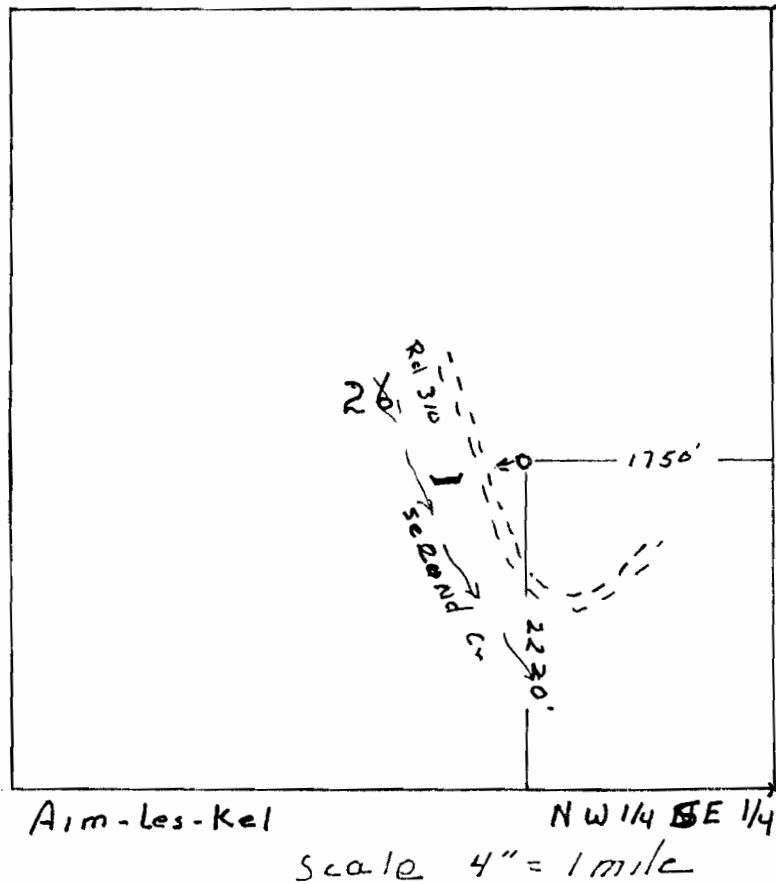

Application No. 66661
Permit No. 49821