



T.27S., R.6W., W.M.

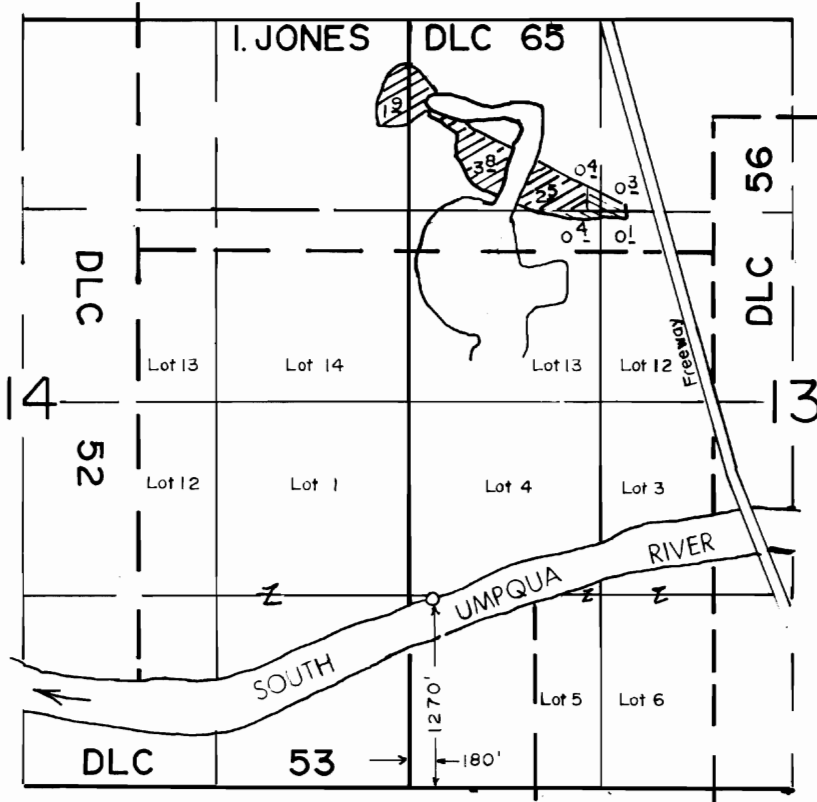

SCALE: 1" = 1320'

FINAL PROOF SURVEY UNDER

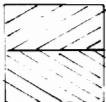

TRANSFER NO 5477

PERMIT 48545

TRANSFER NO. 5477

Application No. 68074.. Permit No. 48545.....
IN NAME OF

.....Veterans Administration Hosp.....

Surveyed JAN. 17. 1990., by B. S. JAMES.....