


T. 37 S., R. 3 E., W.M.

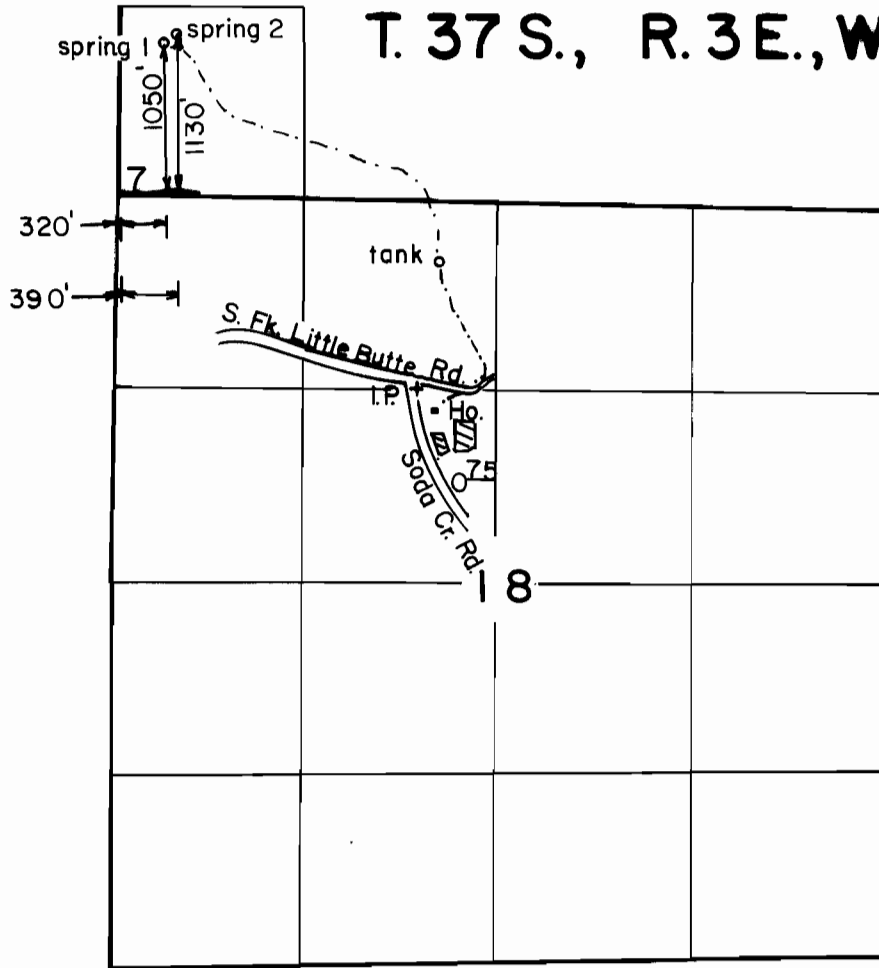

Scale: 1" = 1320'

**FINAL PROOF SURVEY**  
UNDER

Application No. ~~68203~~ Permit No. ~~49400~~...  
IN NAME OF

.....RONALD.....A.....WALCH.....

Surveyed JULY.17. 1991., by R..S...JAMES...