


T.34S., R.1W., W.M.

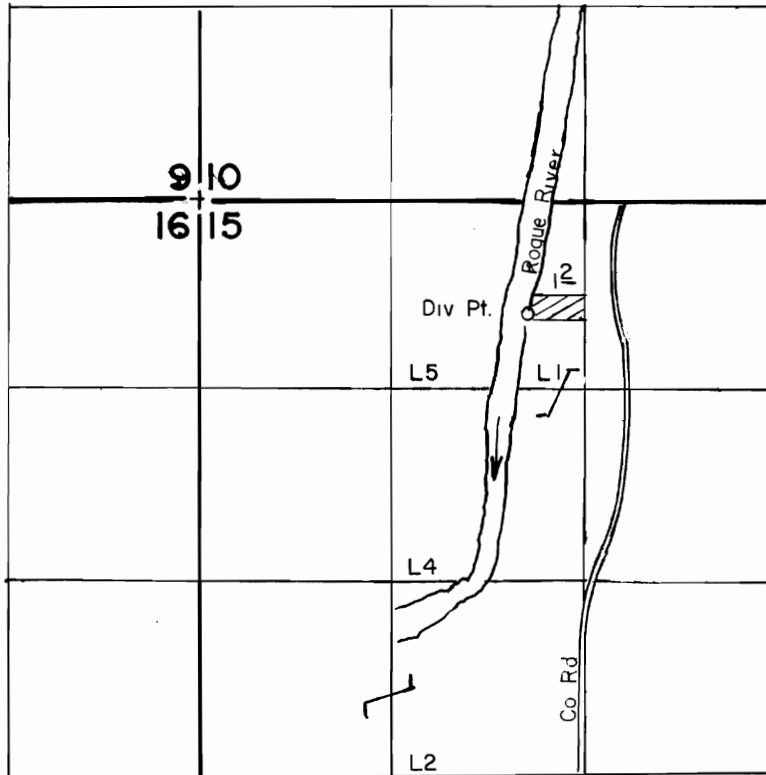

Div Pt Located 800'S & 380'W From The N1/4 Corner Of Section 15

SCALE: 1"=1320'

FINAL PROOF SURVEY
UNDER

TRANSFER NO 5762

Application No. Permit No.
IN NAME OF

RICK D. & APRIL J. STEIGMAN.....

Surveyed MARCH 26 1990., by B.S. JAMES.....